


CERTIFIED RECORD OF LAND CORNER MONUMENTATION

HISTORY OF ORIGINAL CORNER ESTABLISHMENT:

Corner originally established by William H. Odell, Deputy Surveyor under contract number 117, dated July 2, 1866 Original notes states:

T 4 N R 37 E V - 07

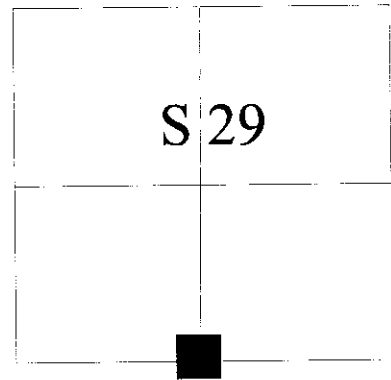

Set post corner for 1/4 section from which:
A Larch 20" in dia. bears N20°W 22 links;
A Larch 18" in dia. bears S25°E 30 links.

In 1978 Douglas M. Ferguson found a set stone and accepts stone as a perpetuation of the 1/4 corner as per Umatilla County Survey #P-113-B.

In 1991 William R. Wells found a basalt stone from which a scribed 10" cut off Larch tree was found S3 1/2°W 27.4'. Wells set a brass cap on an iron pipe and placed the stone on the North side of the monument. Wells marked 4 bearing trees:

- A 8" douglas fir N38°E 18.8' scribed 1/4 S29 BT;
- A 7" larch S77 1/2°E 38.6' scribed 1/4 S32 BT;
- A 8" larch S81 1/2°W 14.6' scribed 1/4 S32 BT;
- A 10" spruce S1°W 26.1' scribed 1/4 S32 BT.

Wells placed bearing object signs on the new bearing trees and set a steel fence post West of the corner with a witness corner sign attached.

DESCRIPTION OF CORNER EVIDENCE FOUND:

Found a 2" iron pipe with a 2 1/2" brass cap marked as shown below from which:

- A 10" larch bears S78°E a distance of 38.6 feet, alive and vigorous with a healed blaze.
- A 13" spruce bears S6°W a distance of 26.1 feet, alive and vigorous with a healed blaze.
- A 11" western larch bears S84°W, a distance of 14.6 feet, alive and vigorous with a healed blaze.
- Northeast bearing tree is dead and downed, it's original position could not be ascertained.

DESCRIPTION OF MONUMENT AND ACCESSORIES I ESTABLISHED TO PERPETUATE THE ORIGINAL LOCATION OF THIS CORNER:

NEW BEARING OBJECTS:


- A 7" spruce bears North 5° East, a distance of 12.85 feet, marked "1/4 S29 BT".

I hereby certify that the above corner point was perpetuated as hereon described on July 6, 2013.
Witness: Daniel O. Inloes

REGISTERED
PROFESSIONAL
LAND SURVEYOR

[Signature]
OREGON
June 2, 2010
JEFFREY S. HSU
83571

Renewal Date: June 30, 2015

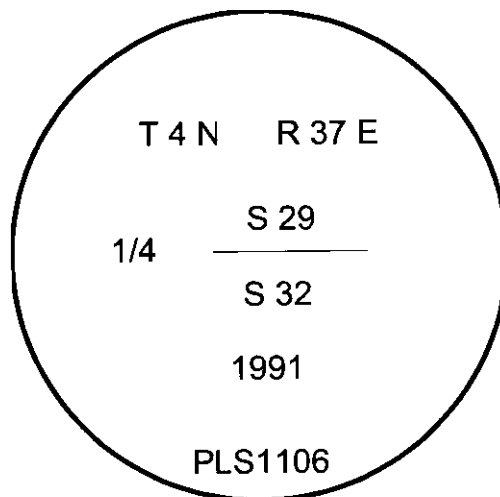

RECEIVED BY
Umatilla County Surveyor
Date: 8/9/2013
Rec'd By: [Signature]
No.: 13-213-C

I used a steel tape and magnetic compass in the establishment of the new accessories. I use 16° East declination. The distance to the new bearing tree is to a 60d spike driven into the right side of the root crown of the bearing trees. Attached brass washer marked OPLS 83571 to BT Blaze.