


CERTIFIED RECORD OF LAND CORNER MONUMENTATION

HISTORY OF ORIGINAL CORNER ESTABLISHED:

Corner shown on Survey 06-103-Ax by W.E.O. Criger, dated June 1951. Indicates he marked a rock in place with 3" wood stke and Bearing Tree at 40°SW.

T 4 N R 37 E Y-13

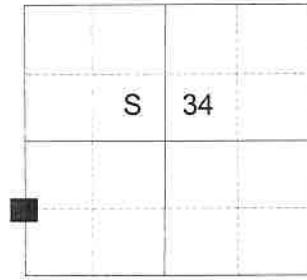

DESCRIPTION OF CORNER EVIDENCE FOUND:

Found 8"x4"x3" stone, firmly planted, with chiseled X and fence post alongside, as noted in Survey 06-103-Ax. Stone falls 1.6 ft. South and 7.19 ft. East of position determined by survey. As Survey 06-103-Ax does not indicate how he arrived at the position, I reject this stone.

DESCRIPTION OF MONUMENT AND ACCESSORIES I ESTABLISHED TO MONUMENT THE ORIGINAL LOCATION OF THIS CORNER:

At position determined by survey, I set a 5/8" x 30" iron pin, 27" in the ground, with a 2 1/2" aluminum cap, marked as shown below, from which:


NEW BEARING OBJECTS:

An 8"x4"x3" stone bears South 77° East, a distance of 7.35 feet, marked X, with fence post 0.5 feet North of stone. A 7" White Fir bears North 18° West, a distance of 7.50 feet, marked S 1/16 S33 BT.

Set steel fence post 0.3 feet Northeasterly.

I hereby certify that the corner was monumented on October 10, 2024.

Witnesses: Kyle Tucker

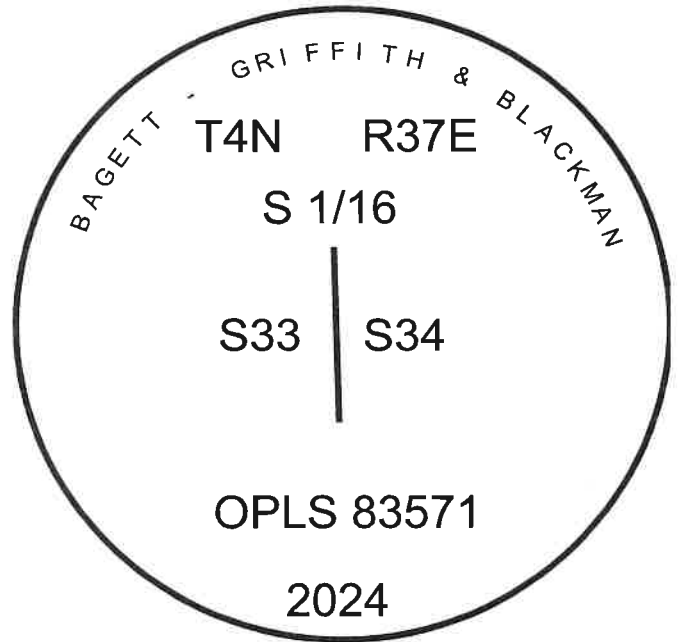

REGISTERED
PROFESSIONAL
LAND SURVEYOR
[Signature]
OREGON
June 2, 2010
JEFFREY S. HSU
83571

Renewal Date: June 30, 2025

I use a tape and compass in the establishment of the new bearing objects. I use 14° East declination. Bearings are measured to a brass washer labeled "OPLS 83571" in the BT blaze at the base of the tree or to the center of the "X". Distances are to a 60D nail in the right side of the base of the center of the tree or to the center of the "X".