


**CERTIFIED RECORD OF LAND CORNER MONUMENTATION**

**HISTORY OF ORIGINAL CORNER ESTABLISHED:**

Corner not previously established.

T 4 N R 37 E Z-16

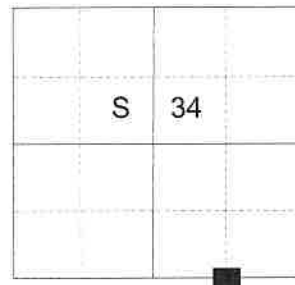

**DESCRIPTION OF CORNER EVIDENCE FOUND:**

None.

**DESCRIPTION OF MONUMENT AND ACCESSORIES I ESTABLISHED TO MONUMENT THE ORIGINAL LOCATION OF THIS CORNER:**

At position determined by survey, I set a 5/8" x 30" iron pin, 28" in the ground, with a 2 1/2" aluminum cap, marked as shown below, from which:

**NEW BEARING OBJECTS:**


An 8" Douglas Fir bears South 63° West, a distance of 12.75 feet, marked E 1/16 S3 BT.

A 20" Douglas Fir bears North 70° West, a distance of 30.35 feet, marked E 1/16 S34 BT.

Set steel fence post approx. 0.5 feet Westerly.

I hereby certify that the corner was monumented on October 10, 2024.

Witnesses: Kyle Tucker

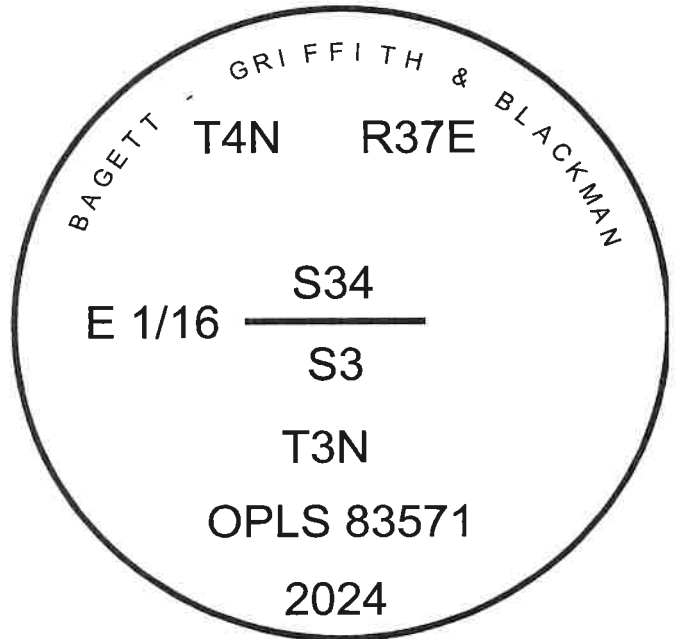

Renewal Date: June 30, 2025

I use a tape and compass in the establishment of the new bearing objects. I use 14° East declination. Bearings are measured to a brass washer labeled "OPLS 83571" in the BT blaze at the base of the tree. Distances are to a 60D nail in the right side of the base of the center of the tree.