

Index

File No. E-1

CORNER RECORD (SEARCH)

(Ref. FSM 7151.4)

Tract or

Survey No. _____

Cor.

No. _____

T 4 N R. 38 E

R.D. Walla Walla County


Umatilla

Merid. Willamette

N.F. Umatilla State

Oregon

CORNER DIAGRAM

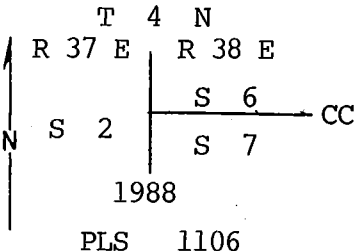

DESCRIBE CORNER MONUMENT FOUND

No trace of original stone, WAS FOUND AFTER A 2 1/2 HOUR SEARCH WITH 2 PERSON CREW. THE CORNER WAS RE-ESTABLISHED ON THE EAST LINE OF SECTION 12 (SENIOR LINE) T4N R37E, BY SINGLE PROPORTION MEASURE BETWEEN EAST 1/4 CORNER OF SECTION 12 AND THE REESTABLISHED N.E. CORNER OF SECTION 12

DESCRIBE BEARING TREES OR OTHER OFFICIAL ACCESSORIES FOUND

USING ROBERT OMEGA'S RETRACEMENT MEASUREMENTS FOR PROPORTIONING.

PHOTO IDENTIFICATION DATA

Photo No. 880-49

Filed At. Umatilla S.O.

Object Ident. Trees

Ident. By WR Walla

Signature

DESCRIBE CORNER LOCATION RELATIVE TO NEAR-BY FEATURES, ALSO HOW TO REACH CORNER

Corner is located on very steep, rocky, unstable hillside about 200' West of ridgetop.

PLANE COORDINATE POSITION DATA

State _____ Zone _____

X _____

Y _____

Estab. By _____

Agency

Signature

Walla R. Walla

Title

Land Surveyor

Division

Headquarters

Pendleton, Or.

Date

9-01-88

FS-7100-52 (3/68)

CORNER RECORD (PERPETUATION)

MONUMENT: DESCRIBE NEW MONUMENT SET, OR WORK DONE TO PRESERVE EXISTING MONUMENT

Since corner point falls on steep unstable hillside, (very rocky) and after spending about 45 minutes to dig 12" in depth, I conclude to remonument with a 5/8" x 30" iron pin. The iron pin was driven into a crack in the rocks and is very stable. Placed a 1½" aluminum cap on the iron pin and marked it as shown in corner diagram. Set a 6' steel fence post South of corner and attached sign 54-4. Compass declination 19° East.

ACCESSORIES: DESCRIBE NEW B^T's WITNESS OBJECTS ETC. ESTABLISHED, OR WORK DONE TO PRESERVE EXISTING EVIDENCE

No bearing trees available for reference so I marked two bearing objects. A 10"x10"x12" out of ground rock in place brs S79°E, 54.8' marked "XBO" on NW face. A 12"x10"x10" out of ground rock in place brs N44°E, 7.2' marked "XBO" on SW face, painted bearing objects red.

Work Done By W.R.Wells Title Land Surveyor Date 9-01-88 State Registration No. ORLS 1106
or Agency

Certified Cor. Record Prepared? Yes XXX Filed At: County Surveyor

Date

REMARKS

Index File No. E-1 T. 4 N. R. 38 E. W.M. Tract or Surv. No.

Cor.