

Index File No. N-3

CORNER RECORD (SEARCH)
(Ref. FSM 7151.4)

Tract or Survey No. _____ Cor. No. N-3


T 4 N R. 38 E

R.D. Walla Walla County _____

Merid. Willamette

N.F. Umatilla State Oregon

CORNER DIAGRAM

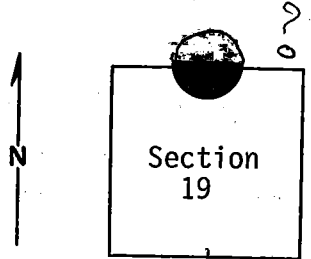

DESCRIBE CORNER MONUMENT FOUND

Brass Cap. Size: $2\frac{1}{2}$ ".
16" above ground; pipe bent. In mound of stone.
(Found 1976 B.C.C.)

DESCRIBE BEARING TREES OR OTHER OFFICIAL ACCESSORIES FOUND

48" fir bears N $7\frac{1}{2}$ ° E, approximately 80' distance, blazed on south face (blaze closed). I placed a blank Forest Service B.T. poster on it.

PHOTO IDENTIFICATION DATA

Photo No. _____
Filed At. _____
Object Ident. _____
Ident. By _____
Signature

DESCRIBE CORNER LOCATION RELATIVE TO NEAR-BY FEATURES, ALSO HOW TO REACH CORNER

Location of B.T. indicates 1/4 Cor. is either for Sec. 18 or 15 common to both Sec. 18 and 19. (or no tree available south) T&H

PLANE COORDINATE POSITION DATA

State _____ Zone _____
X _____
Y _____
Estab. By _____
Agency

Signature
B. Moore

Title
Engineering Technician

Division
Headquarters
S. O.

Date
August 1975

7100-52-(3/68)

CORNER RECORD (PERPETUATION)

MONUMENT: DESCRIBE NEW MONUMENT SET, OR WORK DONE TO PRESERVE EXISTING MONUMENT

ACCESSORIES : DESCRIBE NEW BT'S WITNESS OBJECTS ETC. ESTABLISHED, OR WORK DONE TO PRESERVE EXISTING EVIDENCE

Northwest-southeast fence is 5' west of the bearing tree.

Work Done By _____ Title _____ Date _____ State Registration No. or Agency _____

Certified Cor. Record Prepared ? Yes No Filed At: _____ Date _____

REMARKS

Index. File. No. T. R. M. Tract or Surv. No. Cor. _____