

Index File No. P-17

CORNER RECORD (SEARCH)  
(Ref. FSM 7151.4)


Tract or Survey No. \_\_\_\_\_ Cor. No. 1/4 9

T LN R. 38E

R.D. W.W. County Umatilla & Union Line

Merid. Willamette

N.F. Umatilla State Oregon

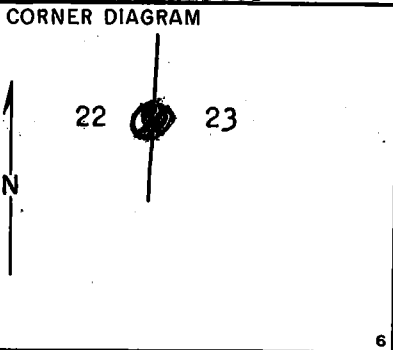

DESCRIBE CORNER MONUMENT FOUND

2

DESCRIBE BEARING TREES OR OTHER OFFICIAL ACCESSORIES FOUND

BT - dead larch snag. Scribing visible.  
BT - stump with visible scribing.

3

PHOTO IDENTIFICATION DATA

Photo No. \_\_\_\_\_  
Filed At. \_\_\_\_\_  
Object Ident. \_\_\_\_\_  
Ident. By \_\_\_\_\_  
*Signature*

7

DESCRIBE CORNER LOCATION RELATIVE TO NEAR-BY FEATURES, ALSO HOW TO REACH CORNER

Found corner by pacing from sec. corner

22	23
27	26

4

PLANE COORDINATE POSITION DATA

State \_\_\_\_\_ Zone \_\_\_\_\_  
X \_\_\_\_\_  
Y \_\_\_\_\_  
Estab. By \_\_\_\_\_  
*Agency*

8

*Signature*  
Woodell

Title Forester Division TM Headquarters W.W. Date 7100-52 (3/68)

CORNER RECORD (PERPETUATION)

MONUMENT: DESCRIBE NEW MONUMENT SET, OR WORK DONE TO PRESERVE EXISTING MONUMENT

ACCESSORIES : DESCRIBE NEW BT'S WITNESS OBJECTS ETC. ESTABLISHED, OR WORK DONE TO PRESERVE EXISTING EVIDENCE

Posted snag with BT poster.

Work Done By \_\_\_\_\_ Title \_\_\_\_\_ Date \_\_\_\_\_ State Registration No. or Agency \_\_\_\_\_

Certified Cor. Record Prepared ? Yes No Filed At: \_\_\_\_\_ Date \_\_\_\_\_

REMARKS

Index File No. P-17 T. R. M. Tract or Surv. No. Cor. \_\_\_\_\_

P-17

PROPERTY CORNER INVESTIGATION


USDA-FOREST SERVICE GPO 940-117  
Index File No. P-17

CORNER RECORD (SEARCH)

Tract or Section No. 1  
County No. 1  
P-17

LOCATION

T. 4N R. 38E  
Mer. WM State OR  
Forest 14 Dist. 6

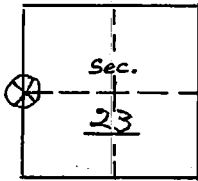

LEGEND

- Corner searched-no evidence
- Corner or accessory found
- Corner marked by perm. mon.

DESCRIPTION OF FOUND CORNER

MATERIAL: None SIZE: \_\_\_\_\_  
 HEIGHT ABOVE GROUND: \_\_\_\_\_ CONDITION: \_\_\_\_\_  
 MARKINGS: \_\_\_\_\_  
Corner needs to be reestablished.

DESCRIPTION OF FOUND ACCESSORIES

old BT with Tag 20" snag old Basal  
 Scar with scribing 1/4 S (Poor Cond.)  
 Faces S72E  
 old BT with Tag old WL Rotten stump  
 No remaining scribing next to 11.1"  
 LP w BT Tag. Faces S66W  
 Followed compass East from Tag on Ad. 6403  
 NOTE: Indicate full investigative details on back of form.

PHOTO IDENTIFICATION

Symbol & date USDA 73071 Line or Roll F 16 Exposure 61616° 1477-22  
 How Identified  Where filed Timber

RECOVERED BY: J.L. Martin

DATE: 7/13/79 TITLE: Forester

R6-7100-59 (9/72)

GPO 796-670

Signature J.L. Martin  
 Agency \_\_\_\_\_  
 Title Forester  
 Division TM  
 Headquarters W.W.  
 Date 7/13/79  
 7100-52 (3/68)

HOW TO REACH CORNER

middle of unit  
5 fall 1979

Line

Cor. No. 1/4