

Index

File No. P-5

CORNER RECORD (SEARCH)


(Ref. FSM 7151.4)

Tract or Survey No. Cor. No. P-5

T 4 N R. 38 E R.D. Walla Walla County

Merid. Willamette N.F. Umatilla State Oregon

CORNER DIAGRAM

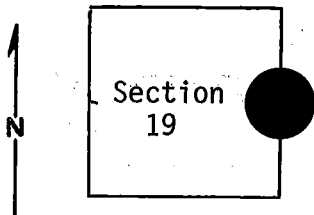

DESCRIBE CORNER MONUMENT FOUND

Brass Cap. Size: 2½".
1' above ground; good condition. Brass cap is not directional. North is south.

DESCRIBE BEARING TREES OR OTHER OFFICIAL ACCESSORIES FOUND

N 87° E, 7' distance from corner is 40" fir with closed west blaze, hole at bottom of blaze has scribe mark: S.
Due west, 11' distance is 26" dead snag blazed east face scribed: ¼S 19 B.T.

PHOTO IDENTIFICATION DATA

Photo No.

Filed At.

Object Ident.

Ident. By

Signature

PLANE COORDINATE POSITION DATA

State Zone

X

Y

Estab. By

Agency

Signature

Title

Division

Headquarters

Date

B. Moore

Engineering Technician

S. O.

August 1975

7100-52-(3/68)

CORNER RECORD (PERPETUATION)

MONUMENT: DESCRIBE NEW MONUMENT SET, OR WORK DONE TO PRESERVE EXISTING MONUMENT

9

ACCESSORIES : DESCRIBE NEW BT's WITNESS OBJECTS ETC. ESTABLISHED, OR WORK DONE TO PRESERVE EXISTING EVIDENCE

I placed Forest Service B.T. posters on the 2 bearing trees.

10

Work Done By _____ Title _____ Date _____ State Registration No. or Agency _____

Certified Cor. Record Prepared ? Yes No Filed At: _____ Date _____

11

REMARKS

12

Index File No. T. R. M. Tract or Surv. No. Cor. 13