

USDA-FOREST SERVICE

Index
File No. S-5

CORNER RECORD (SEARCH)

(Ref. FSM 7151.4)

Tract or
Survey No. _____ Cor.
No. _____


T 4N R. 38E

R.D. WW County UMATILLA

Merid. W

N.F. UMATILLA State OREGON

CORNER DIAGRAM

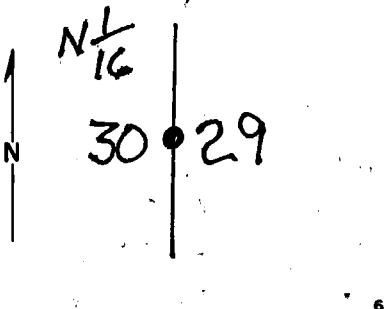

DESCRIBE CORNER MONUMENT FOUND

3/4" iron pipe 10" exposed leans west.
~~Pipe cast 0.95 of mon. set.~~

DESCRIBE BEARING TREES OR OTHER OFFICIAL ACCESSORIES FOUND

NONE

PHOTO IDENTIFICATION DATA

Photo No. _____
Filed At. _____
Object Ident. _____
Ident. By _____
Signature

DESCRIBE CORNER LOCATION RELATIVE TO NEAR-BY FEATURES, ALSO HOW TO REACH CORNER

FOLLOW POSTED LINE SOUTH 1320 FT FROM
NW Sec COR 29 to corner.

PLANE COORDINATE POSITION DATA

State _____ Zone _____
X _____
Y _____
Estab. By _____
Agency

Signature
Edwin A. Styrker

Title
PAS

Division
Headquarters

Date
8/4/89

FS-7100-52 (3/68)

CORNER RECORD (PERPETUATION)

MONUMENT: DESCRIBE NEW MONUMENT SET, OR WORK DONE TO PRESERVE EXISTING MONUMENT

SET 2 1/2" x 30" ALUM. MON.
26" in ground. No stones
available. CAP marked:

T4N R38E WM
N 1/6
530 ——— 529
1989

MY MONUMENT IS SET AT POINT OCCUPIED BY RECOVERED STRYKER PHS 2060

ACCESSORIES: DESCRIBE NEW BT'S WITNESS OBJECTS ETC. ESTABLISHED, OR WORK DONE TO PRESERVE EXISTING EVIDENCE

BT 14" True fir bears N 1/6 E at 29.3 ft.
scribed " N 1/6 529 BT "

BT 15" Spruce bears S 84 E at 21.5 ft.
scribed " N 1/6 529 BT "

Placed brass washers "PHS 2060" at base of both blazes 10

Work Done By E.A. Stryker Title OPHS Date 8/4/89 State Registration No. 2060
or Agency

Certified Cor. Record Prepared? No Filed At: Umatilla Cty Date AUG 89 11

REMARKS

Painted Red Bands around both BT's
Placed 54-3 signs and 54-4 signs on both BT's
Placed 54-9 sign and 54-2 sign on steel post set
5 ft NORTH OF CORNER

Index File No. 5-5 T. 4N R. 38E M. W Tract or Surv. No. W Cor. 13
GPO: 1982 O-382-659

Index File No. S-5

CORNER RECORD (SEARCH)

(Ref. FSM 7151.4)

Tract or Survey No. _____ Cor. No. S-5


T 4 N R. 38 E

R.D. Walla Walla County Umatilla

Merid. Willamette

N.F. Umatilla State Oregon

CORNER DIAGRAM

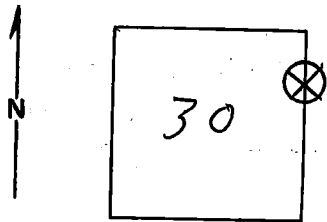

DESCRIBE CORNER MONUMENT FOUND

County Surveyor's records show:
3/4" x 30" Iron Pipe

DESCRIBE BEARING TREES OR OTHER OFFICIAL ACCESSORIES FOUND

PHOTO IDENTIFICATION DATA

Photo No. _____
Filed At. _____
Object Ident. _____
Ident. By _____
Signature

DESCRIBE CORNER LOCATION RELATIVE TO NEAR-BY FEATURES, ALSO HOW TO REACH CORNER

(over)

PLANE COORDINATE POSITION DATA

State _____ Zone _____
X _____
Y _____
Estab. By _____
Agency

Signature _____ Title _____ Division _____ Headquarters _____ Date _____

CORNER RECORD (PERPETUATION)

MONUMENT: DESCRIBE NEW MONUMENT SET, OR WORK DONE TO PRESERVE EXISTING MONUMENT

ACCESSORIES : DESCRIBE NEW BT'S WITNESS OBJECTS ETC. ESTABLISHED, OR WORK DONE TO PRESERVE EXISTING EVIDENCE

9

10

Work Done By Lammason Title ORLS Date 1971 State Registration No. or Agency

Certified Cor. Record Prepared ? Yes No Filed At: Date

11

REMARKS

12

Index File No. 1 T. R. M. Tract or Surv. No. Cor.

13