

USDA-FOREST SERVICE

Index
File No. T-17

CORNER RECORD (SEARCH)

(Ref. FSM 7151.4)

Tract or
Survey No. _____ Cor.
No. _____


T 4N R. 38E

R.D. Walla Walla County Umatilla

Merid. Willamette

N.F. Umatilla State Oregon

CORNER DIAGRAM

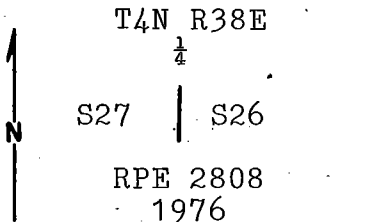

DESCRIBE CORNER MONUMENT FOUND

Found $2\frac{1}{2}$ " brass cap on a $2\frac{1}{2}$ " galv. iron pipe protruding 4" out of the ground.

DESCRIBE BEARING TREES OR OTHER OFFICIAL ACCESSORIES FOUND

A 18" western larch bears N 53° W, 11.2' with healed blaze. (Original bearing tree)
A 13" snapped off western larch bears S 60° E, 6.6' with scribes visible on previously opened blaze. (Orig. bearing tree)
A 14" dead western larch snag bears S 18° E, 20.5' with scribes vis. on partly healed double blaze (RPE 2808)

PHOTO IDENTIFICATION DATA

Photo No. _____
Filed At. _____
Object Ident. _____
Ident. By _____
Signature

DESCRIBE CORNER LOCATION RELATIVE TO NEAR-BY FEATURES, ALSO HOW TO REACH CORNER

record bearing was S 40° E).

PLANE COORDINATE POSITION DATA

State _____ Zone _____
X _____
Y _____
Estab. By _____
Agency

Corner is located about 250' east of a road. There is a location poster on this road north of the corner.

Signature

Will R. Wells

Title
PLS

Division

Headquarters
Pendleton, OR

Date
9/4/91

FS-7100-52 (3/68)

CORNER RECORD (PERPETUATION)

MONUMENT: DESCRIBE NEW MONUMENT SET, OR WORK DONE TO PRESERVE EXISTING MONUMENT

Maintained the existing monument by cleaning up around it and mounding with earth. Set steel fence post north of corner with sign 54-9 attached.

ACCESSORIES : DESCRIBE NEW BT^s, WITNESS OBJECTS ETC. ESTABLISHED, OR WORK DONE TO PRESERVE EXISTING EVIDENCE

Marked 4 new bearing trees:

- A 23" western larch bears N $14\frac{1}{2}^{\circ}$ E, 63.4' scribed $\frac{1}{4}$ " S26 BT.
 - A 25" englemann spruce bears N $85\frac{1}{2}^{\circ}$ E, 41.5' scribed $\frac{1}{4}$ " S26 BT.
 - A 6" englemann spruce bears N 62° W, 19.2' scribed $\frac{1}{4}$ " S27 BT.
 - A 9" englemann spruce bears S 54° W, 4.1' scribed $\frac{1}{4}$ " S27 BT.
- New bearing trees have a brass washer stamped PLS 1106 nailed to the face of blaze. Attached sign 54-3 and 54-9 and painted face of blaze and a 6" red band around each bearing trees.

Work Done By W. R. Wells Title PLS Date 9/4/91 State Registration No. 1106
or Agency

Certified Cor. Record Prepared? Yes No Filed At: Umatilla Co. Surveyor Off. Date 12/91

REMARKS

Index File No. T-17 T. 4N

R. 38E

M. Will.

Tract or Surv. No.

Cor.


Index
File No. T 17
T 4 N 38 E
Merid. Willamette

CORNER RECORD (SEARCH)

(Ref. FSM 7151.4)

Tract or Survey No. _____ Cor. No. T 17
R.D. Walla Walla County Umatilla
N.F. Umatilla State Oregon

CORNER DIAGRAM

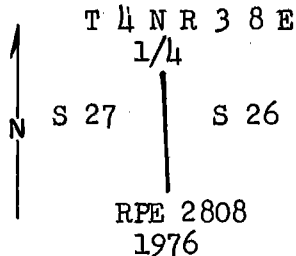

DESCRIBE CORNER MONUMENT FOUND

NONE

DESCRIBE BEARING TREES OR OTHER OFFICIAL ACCESSORIES FOUND

A larch 18" diam. with healed blaze bears N 53° W., 11.22 ft. (17 lks) with 1971 BT tag.
A larch 14" diam, with previously opened blaze bears S 60° E., 6.6 ft. (10 lks) with visible scribing 1/4 S.

PHOTO IDENTIFICATION DATA

Photo No. _____
Filed At. _____
Object Ident. _____
Ident. By _____
Signature

DESCRIBE CORNER LOCATION RELATIVE TO NEAR-BY FEATURES, ALSO HOW TO REACH CORNER

0.6 miles northerly on road to Dayton, Wash., from intersection with road to Troy, Oregon to location tag. Corner is south 7 chains (460 ft.)

PLANE COORDINATE POSITION DATA

State _____ Zone _____
X _____
Y _____
Estab. By _____

James D. Hanley
Signature
James D. Hanley

Title _____ Division _____ Headquarters _____ Date 7/13/76
ORPE 2808 7100-52 (3/68)

CORNER RECORD (PERPETUATION)

MONUMENT: DESCRIBE NEW MONUMENT SET, OR WORK DONE TO PRESERVE EXISTING MONUMENT

Set a 2 1/2" brass cap on a 2" iron pipe 31" long in earth mound 6" above ground with a 6" steel fence post alongside with a sign 54-4 attached.

ACCESSORIES : DESCRIBE NEW BT'S WITNESS OBJECTS ETC. ESTABLISHED, OR WORK DONE TO PRESERVE EXISTING EVIDENCE

A larch 1 1/4" dia. bears S 40° E., 20.5 ft. dist marked 1/4 S 26 BT with a sign 54-3 attached 6" below a band of red paint and a brass washer marked RFE 2808 nailed flush with BT blaze.

Work Done By James D. Hanley Title Engineer Date 7/13/76 State Registration No. ORPE 2808
Or Agency

Certified Cor. Record Prepared ? Yes XXX Filed At: Pendleton, Oregon Date 8// /76

REMARKS

Index File No. T 17 T. 4 N R. 38 E W. M. Tract or Surv. No. Cor., 13