

USDA-FOREST SERVICE

Index

File No. V-7

CORNER RECORD (SEARCH)

(Ref. FSM 7151.4)

Tract or

Survey No. _____

Cor.

No. V-7


T 4N R. 38E

R.D. WALLA WALLA County WIMATILLA

Merid. Willamette

N.F. WIMATILLA State Oregon

CORNER DIAGRAM

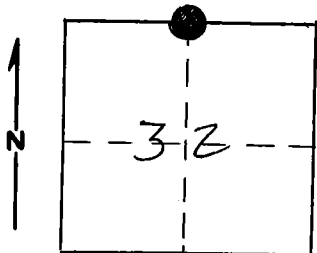

DESCRIBE CORNER MONUMENT FOUND

1" GALV. IRON PIPE WITH 2" BRASS CAP MARKED BY GLO IN 1939.

DESCRIBE BEARING TREES OR OTHER OFFICIAL ACCESSORIES FOUND

A 12" LI. PINE BEARS N20E (RECORD N15E) 8' FT. (RECORD 13LKS) BLAZE EVIDENT & PARTIAL SCRIBES VISIBLE. SINGLE BLAZE.

Urgentous.

DESCRIBE CORNER LOCATION RELATIVE TO NEAR-BY FEATURES, ALSO HOW TO REACH CORNER

From the Jct of ROAD 6401 & 6401-019 drive about 0.8 mile, WACK SOUTH ABOUT 700 FEET TO CORNER.

PHOTO IDENTIFICATION DATA

Photo No. _____

Filed At. _____

Object Ident. _____

Ident. By _____

Signature

PLANE COORDINATE POSITION DATA

State _____ Zone _____

X _____

Y _____

Estab. By _____

Agency

Signature

Gregory T. Black

Title

Surveyor

Division

Headquarters

Date

7-85

7100-52-(3,68)

CORNER RECORD (PERPETUATION)

MONUMENT: DESCRIBE NEW MONUMENT SET, OR WORK DONE TO PRESERVE EXISTING MONUMENT

SET fence post S^o EAST with 54-2 & 54-4 sign attached.

ACCESSORIES : DESCRIBE NEW BT'S WITNESS OBJECTS ETC. ESTABLISHED, OR WORK DONE TO PRESERVE EXISTING EVIDENCE

OLD BT:

A 12" L. pine BEARS N20E 8.0 FT. PAINTED Red BAND AROUND TREE & PLACED ATTN SIGN ON TREE.

new BT.

A 15" spruce BEARS S15E 26.8 FT MKd 1/4 S32 BT. single blay. PAINTED Red BAND AROUND TREE & PLACED ATTN SIGN & BT SIGNS ON TREE 10

Work Done By Greg Blackman Title Surveyor Date 7-85 State Registration No. OPRS 991 or Agency

Certified Cor. Record Prepared? Yes No Filed At: Umatilla County Surveyor Date 7-85 11

REMARKS