

Index

File No. X-11

CORNER RECORD (SEARCH)

(Ref. FSM 7151.4)

Tract or

Survey No. \_\_\_\_\_

Cor.

No. \_\_\_\_\_

T 4N R. 30E

R.D.

Walla Walla

County

Umatilla

Merid. Will


N.F.

Umatilla

State

OR

CORNER DIAGRAM

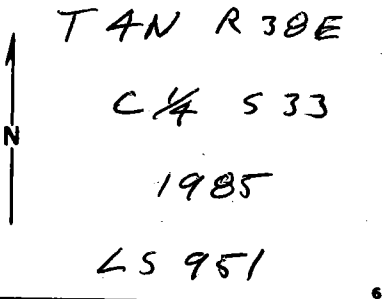

DESCRIBE CORNER MONUMENT FOUND

NONE

DESCRIBE BEARING TREES OR OTHER OFFICIAL ACCESSORIES FOUND

NONE

PHOTO IDENTIFICATION DATA

Photo No. \_\_\_\_\_

Filed At. \_\_\_\_\_

Object Ident. \_\_\_\_\_

Ident. By \_\_\_\_\_

*Signature*

PLANE COORDINATE POSITION DATA

State \_\_\_\_\_ Zone \_\_\_\_\_

X \_\_\_\_\_

Y \_\_\_\_\_

Estab. By \_\_\_\_\_

*Agency*

DESCRIBE CORNER LOCATION RELATIVE TO NEAR-BY FEATURES, ALSO HOW TO REACH CORNER

From Jct. Rd # 6401 with #64

Go East on Rd. #64 0.3 mile

Corner lies 350' south of 546 sign

*Signature*  
Dennis Edward

Title

LS 951

Division

Headquarters

Hermiston

Date

7/19/85

7100-52 (3. 68)

CORNER RECORD (PERPETUATION)

MONUMENT: DESCRIBE NEW MONUMENT SET, OR WORK DONE TO PRESERVE EXISTING MONUMENT

set 2" x 30" I. Pipo with 2 1/2" B.C stamped as diagram 28" deep.

ACCESSORIES: DESCRIBE NEW BT'S WITNESS OBJECTS ETC. ESTABLISHED, OR WORK DONE TO PRESERVE EXISTING EVIDENCE

Dravo a steel Fence post 3.4 Ft. East of cor. with 54-9 signs  
a 16" Spruce bears S 42° W 21.8 Ft. scribed. C 1/4 S 33 BT.  
a 7" Fir bears N 80° E 37.0 Ft. scribed. C 1/4 S 33 BT  
I nailed Alum. tugs stamped 951 to Btm. Blazes & painted Blaze Red.  
I painted Red Band around BT's & nailed 54-3 & 54-9 signs on.

Work Done By G. O. Edwards Title LS 951 Date 7/19/85 State Registration No. OR 951  
or Agency

Certified Cor. Record Prepared?  Yes  No Filed At: Pentleton, OR Date 7/85

REMARKS