

Index

File No. X-13

CORNER RECORD (SEARCH)

(Ref. FSM 7151.4)

Tract or

Survey No. _____

Cor.

No. 1/4


T 4N R. 30E

R.D. Walla Walla County Umatilla

Merid. W:11

N.F. Umatilla State OR

CORNER DIAGRAM

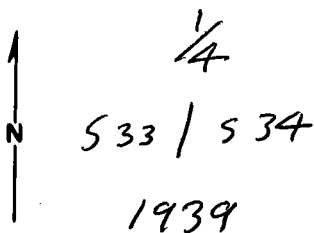

DESCRIBE CORNER MONUMENT FOUND

End 1" Iron pipe with B.C. stamped as diagram

DESCRIBE BEARING TREES OR OTHER OFFICIAL ACCESSORIES FOUND

a 20" down fir ^{root hole} bears N 68° E 20' partially healed
 a 18" fir snag bears N 71 1/2° W 20' Blaze rotted

PHOTO IDENTIFICATION DATA

Photo No. _____

Filed At. _____

Object Ident. _____

Ident. By _____

Signature

PLANE COORDINATE POSITION DATA

State _____ Zone _____

X _____

Y _____

Estab. By _____

Agency

DESCRIBE CORNER LOCATION RELATIVE TO NEAR-BY FEATURES, ALSO HOW TO REACH CORNER

From Jct Rd. #6401 with Rd #64.
 Go East on Rd #64 ONE mile.
 Corner lies 1450 ft. South of 54-6
 sign on tree

Signature

G. Dennis Cleward

Title

LS 951

Division

Headquarters

Hermiston

Date

7/19/95

7100-52 (3. 68)

CORNER RECORD (PERPETUATION)

MONUMENT: DESCRIBE NEW MONUMENT SET, OR WORK DONE TO PRESERVE EXISTING MONUMENT

I drove a steel fence post 3 ft. west & attached
54-4 sign

ACCESSORIES: DESCRIBE NEW BT'S WITNESS OBJECTS ETC. ESTABLISHED, OR WORK DONE TO PRESERVE EXISTING EVIDENCE

a 10" Fir bears N 80°E 22.2 ft. scribed 1/4 534 BT

a 23" spruce bears S 66°W 42.4 ft scribed 1/4 533 BT

I nailed alum. tags stamped 951 to Btm Blazes & painted Red.

Painted Rod Band around BT's and nailed 54-3 & 54-4 signs on

Work Done By G. D. Edwards Title LS Date 7/19/85 State Registration No. OR 951
or Agency

Certified Cor. Record Prepared? Yes No Filed At: Pendleton OR Date 7/185

REMARKS

Index File No. X-13 T. 4N R. 38E M. 411

Tract or Surv. No.

Cor. 1/4