

Index

File No. X-14

CORNER RECORD (SEARCH)

(Ref. FSM 7151.4)

Tract or

Survey No. \_\_\_\_\_

Cor.

No. 1/16


T 4N R. 38E

R.D. Walla Walla County Umatilla

Merid. Will

N.F. Umatilla State OR

CORNER DIAGRAM

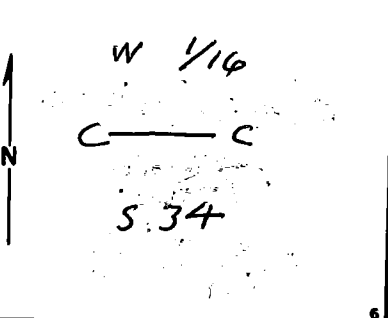

DESCRIBE CORNER MONUMENT FOUND

$\frac{1}{2}$ " Iron pipe Res. N.  $34^{\circ}00'31''$  W 22.00 ft.  
from Corner  
No Record.

DESCRIBE BEARING TREES OR OTHER OFFICIAL ACCESSORIES FOUND

None

PHOTO IDENTIFICATION DATA

Photo No. \_\_\_\_\_

Filed At. \_\_\_\_\_

Object Ident. \_\_\_\_\_

Ident. By \_\_\_\_\_

Signature

PLANE COORDINATE POSITION DATA

State \_\_\_\_\_ Zone \_\_\_\_\_

X \_\_\_\_\_

Y \_\_\_\_\_

Estab. By \_\_\_\_\_

Agency

DESCRIBE CORNER LOCATION RELATIVE TO NEAR-BY FEATURES, ALSO HOW TO REACH CORNER

From Jct Rd # 6401 with # 64  
Go East on # 64 1.6 mile to  
type "A" F.S. sign.  
Corner lies 1105 ft west of Type "A" sign.

Signature

Title

Division

Headquarters

Date

7100-52 (3. 68)

*E. Dennis Edward*

LS

7/19/85

CORNER RECORD (PERPETUATION)

MONUMENT: DESCRIBE NEW MONUMENT SET, OR WORK DONE TO PRESERVE EXISTING MONUMENT

Set a 2" x 30' iron pipe 29" in ground with BC. stamped

CW 1/16 S34  
1985  
LS 951

Drove a stool fence post 3' East and attached 54-9 sign

ACCESSORIES: DESCRIBE NEW BT'S WITNESS OBJECTS ETC. ESTABLISHED, OR WORK DONE TO PRESERVE EXISTING EVIDENCE

a 16" fir bears N 60° E 9.5 ft scribed CW 1/16 S34 BT

a 10" fir bears S 15° E 11.4 ft scribed CW 1/16 S34 BT

I Painted blazes red and nailed an alum tag stamped 951 to BT's.

Painted a red band around BT's and nailed 54-3 and 54-9 signs on.

Work Done By G. R. Edwards Title LS Date 7/19/85 State Registration No. DR 951  
or Agency

Certified Cor. Record Prepared?  Yes  No Filed At: Pendleton, OR Date 7/19/85

REMARKS