

Index

File No. X-17

CORNER RECORD (SEARCH)

(Ref. FSM 7151.4)

Tract or

Survey No. _____

Cor.

No. _____


T 4 N R. 30 E

R.D. Walla Walla County Umatilla

Merid. Will

N.F. Umatilla State OR

CORNER DIAGRAM

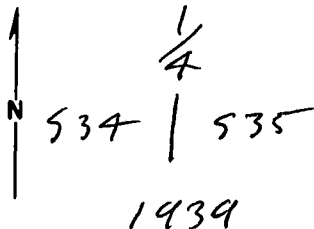

DESCRIBE CORNER MONUMENT FOUND

Find 1" Iron pipe with B.C. in a mound of stone (firm) marked as diagram

DESCRIBE BEARING TREES OR OTHER OFFICIAL ACCESSORIES FOUND

A 36" Fir bears S65°E 7.9ft. some marks vis on chopped out blaze

A 33" Fir bears S87½°W 56.1ft. Blaze Healed not opened.

PHOTO IDENTIFICATION DATA

Photo No. 880-25

Filed At. Pendleton

Object Ident. Precise

Ident. By D. Edward

Signature

PLANE COORDINATE POSITION DATA

State _____ Zone _____

X _____

Y _____

Estab. By _____

Agency

DESCRIBE CORNER LOCATION RELATIVE TO NEAR-BY FEATURES, ALSO HOW TO REACH CORNER

From Jct. Rd # 6403 with Rd # 64
Go south on # 64 0.4 mile.
Corner lies S 60°W 270' from 54-5 sign on tree.

Signature

Title

Division

Headquarters

Date

G. Dennis Edward

LS 951

Hermiston

7/19/85

7100-52 (3. 68)

CORNER RECORD (PERPETUATION)

MONUMENT : DESCRIBE NEW MONUMENT SET, OR WORK DONE TO PRESERVE EXISTING MONUMENT

I drove a steel fence post 3ft. NE. of cor. & attached 54-4 sign

ACCESSORIES : DESCRIBE NEW BT'S WITNESS OBJECTS ETC. ESTABLISHED, OR WORK DONE TO PRESERVE EXISTING EVIDENCE

New BT

A 7" Fir bears N 56°W 37.1 ft. scribed 1/4 S 34 BT
I nailed alum. Tag # 951 to Bottom Blazo & painted Blazo Red
Painted a red Band around all BT's & attached 54-3 & 54-4 signs.

Work Done By: G. D. Edwards Title LS Date 7/19/85 State Registration No. OR 951
or Agency
Certified Cor. Record Prepared? No Filed At: Pendleton OR Date 7/19/85

REMARKS

USDA-FOREST SERVICE

Index

File No. X 17

T 4N R. 38E

Merid. Will

CORNER RECORD (SEARCH)

(Ref. FSM 7151.4)

Tract or

Survey No. _____

Cor.


No. _____

R.D. Walla Walla County Umatilla/Union

N.F. Umatilla State Oregon

CORNER DIAGRAM

T4N R38E

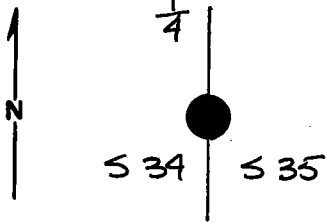

DESCRIBE CORNER MONUMENT FOUND

Found iron post, 1" dia., with brass cap in mound of stones, firmly in place.

DESCRIBE BEARING TREES OR OTHER OFFICIAL ACCESSORIES FOUND

Orig. 32" Sir is alive ^{to} with scribes visible where it was opened in 1939, and bears $565^{\circ}E$, 8 ft from corner

Orig. 30" Sir is down and lying on face, so not sure, but bears $587\frac{1}{2}^{\circ}W$, 56 ft from corner.

PHOTO IDENTIFICATION DATA

Photo No. _____

Filed At. _____

Object Ident. _____

Ident. By _____

Signature

PLANE COORDINATE POSITION DATA

State _____ Zone _____

X _____

Y _____

Estob. By _____

Agency

DESCRIBE CORNER LOCATION RELATIVE TO NEAR-BY FEATURES, ALSO HOW TO REACH CORNER

Put up K-tag along Rd 64.

Signature

Title

Division

Headquarters

Date

7100-52-(3,68)

Aue Newstetter

Civil Eng Tech

SO

6/25/84

4

5

CORNER RECORD (PERPETUATION)

MONUMENT: DESCRIBE NEW MONUMENT SET, OR WORK DONE TO PRESERVE EXISTING MONUMENT

ACCESSORIES : DESCRIBE NEW BT'S WITNESS OBJECTS ETC. ESTABLISHED, OR WORK DONE TO PRESERVE EXISTING EVIDENCE

Work Done By _____ Title _____ Date _____ State Registration No. or Agency _____

Certified Cor. Record Prepared? Yes No Filed At: _____ Date _____

REMARKS

Index File No. T. R. M. Tract or Surv. No. Cor.