

USDA-FOREST SERVICE

Index  
File No. X-7  
T 4N R. 38E  
Merid. Willamette


CORNER RECORD (SEARCH)

(Ref. FSM 7151.4)

R.D. WALLA WALLA County LIMATILLA  
N.F. LIMATILLA State OREGON

Tract or Survey No. \_\_\_\_\_ Cor. No. X-7

CORNER DIAGRAM

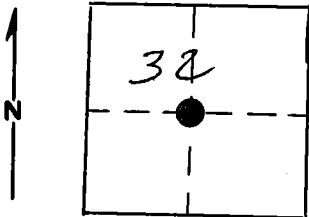

DESCRIBE CORNER MONUMENT FOUND

FND 1" IRON PIPE WITH BRASS CAP  
set by DON STABLER - SURVEY NO I-156-B

DESCRIBE BEARING TREES OR OTHER OFFICIAL ACCESSORIES FOUND

FOUND 16" DIAMETER STUMP LOOSE ON GROUND BT  
Scribe visible. STUMP BEARS SOUTH 60 FT.

PHOTO IDENTIFICATION DATA

Photo No. \_\_\_\_\_  
Filed At. \_\_\_\_\_  
Object Ident. \_\_\_\_\_  
Ident. By \_\_\_\_\_  
Signature \_\_\_\_\_

PLANE COORDINATE POSITION DATA

State \_\_\_\_\_ Zone \_\_\_\_\_  
X \_\_\_\_\_  
Y \_\_\_\_\_  
Estab. By \_\_\_\_\_  
Agency \_\_\_\_\_

DESCRIBE CORNER LOCATION RELATIVE TO NEAR-BY FEATURES, ALSO HOW TO REACH CORNER

FROM THE POINT THE POSTED LINE ON THE EAST  
LINE OF THE SW 1/4 CROSSES HIGHWAY 284 - WALK  
NORTH ALONG POSTED LINE 100 FT.

Signature Oregon T. Blackman Title Surveyor Division \_\_\_\_\_ Headquarters \_\_\_\_\_ Date 7-85  
7100-52 (3, 68)

CORNER RECORD (PERPETUATION)

MONUMENT: DESCRIBE NEW MONUMENT SET, OR WORK DONE TO PRESERVE EXISTING MONUMENT

MONUMENT WAS LOOSE IN GROUND, TIGHTENED MONUMENT, DROVE FENCE POSTS 50 WEST & 50 SOUTH OF MON. PLACED ATTN SIGN ON POST TO SOUTH.

ACCESSORIES: DESCRIBE NEW BT'S WITNESS OBJECTS ETC. ESTABLISHED, OR WORK DONE TO PRESERVE EXISTING EVIDENCE

PLACED ATTN SIGN & BT. SIGN ON OLD BT. - PAINTED BAND AROUND BT.  
New BT. A 19" TAMARACK BEARS S 57E 32.6 FT. MKD X BT.  
A 17" TAMARACK BEARS S 45W 9.3 FEET MKD C 1/4 S 32 BT.  
PAINTED BAND AROUND BT'S, & PLACED SIGNS ON BT'S,

Work Done By Greg Blackman Title Surveyor Date 7-85 State Registration No. or Agency ORLS 991

Certified Cor. Record Prepared?  Yes  No Filed At Umatilla County Surveyor Date 7-85

REMARKS