

USDA-FOREST SERVICE

Index

File No. X-8

CORNER RECORD (SEARCH)

(Ref. FSM 7151.4)

Tract or

Survey No. _____

Cor.

No. X-8

T 4N R. 38E

R.D. WALLA WALLA


County UMATILLA

Merid. Willamette

N.F. UMATILLA

State Oregon

CORNER DIAGRAM

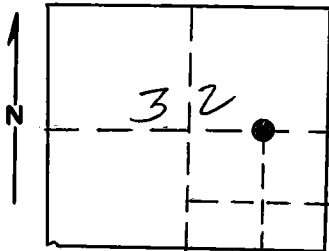

DESCRIBE CORNER MONUMENT FOUND

NOT prev. set.

DESCRIBE BEARING TREES OR OTHER OFFICIAL ACCESSORIES FOUND

NONE

PHOTO IDENTIFICATION DATA

Photo No. _____

Filed At. _____

Object Ident. _____

Ident. By _____

Signature

6

DESCRIBE CORNER LOCATION RELATIVE TO NEAR-BY FEATURES, ALSO HOW TO REACH CORNER

Corner is located on south side of Highway at toe of fill.

3

PLANE COORDINATE POSITION DATA

State _____ Zone _____

X _____

Y _____

Estab. By _____

Agency

8

Signature
Gregory T. Blackman

Title

Surveyor

Division

Headquarters

Date

9-85

7100-52 (3, 68)

4

5

CORNER RECORD (PERPETUATION)

MONUMENT: DESCRIBE NEW MONUMENT SET, OR WORK DONE TO PRESERVE EXISTING MONUMENT

Set 2 1/2 x 30" Aluminum pipe with 3" Cap 24" IN GROUND
& RAISED MOUND OF STONE

ACCESSORIES : DESCRIBE NEW BT'S WITNESS OBJECTS ETC. ESTABLISHED, OR WORK DONE TO PRESERVE EXISTING EVIDENCE

Set wood post with wood sign 50 North of corner. Set
metal fence post 50 East with land survey mon. sign
B.T's.

A 6" spruce BEARS N 87 E 290 Feet med X BT.

A 22" spruce BEARS N 31 E 943 Feet MKD CE 1/16 S 32 BT.

Work Done By Greg Blackman Title Surveyor Date 7-85 State Registration No. 0PL8 991
or Agency

Certified Cor. Record Prepared? Yes No Filed At: WILLAMETTE County Surveyor Date 7-85

REMARKS

Index File No. X-8 T. 4N R. 38E M. Willamette Tract or Surv. No.

Cor. CE 1/16