

USDA-FOREST SERVICE

Index

File No. 217

CORNER RECORD (SEARCH)

(Ref. FSM 7151.4)

Tract or

Survey No. _____

Cor.

No. _____


T 4N R. 38E

R.D. Walla Walla County Umatilla/Union

Merid. Will

N.F. Umatilla State Oregon

CORNER DIAGRAM

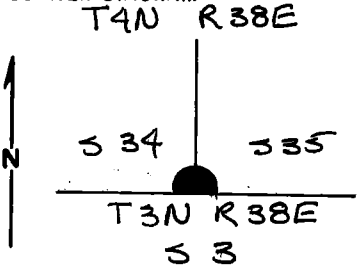

DESCRIBE CORNER MONUMENT FOUND

Found iron post, 2" dia., with brass cap out of ground and lying loose.

DESCRIBE BEARING TREES OR OTHER OFFICIAL ACCESSORIES FOUND

Orig. 28" pine is alive, now 30", with scribing visible and bears N 24° E, 132 ft (record dist. appears to be wrong) from corner

Orig. 30" fir is alive, now 35", with scribing visible (large branch in front of main trunk) and bears N 7° W and 156 ft (record dist. appears to be wrong) from corner.

DESCRIBE CORNER LOCATION RELATIVE TO NEAR-BY FEATURES, ALSO HOW TO REACH CORNER

Road 64 is just above the corner and location tag is nailed to guard rail post

PHOTO IDENTIFICATION DATA

Photo No. _____

Filed At. _____

Object Ident. _____

Ident. By _____

Signature

PLANE COORDINATE POSITION DATA

State _____ Zone _____

X _____

Y _____

Estob. By _____

Agency

Signature

Title

Division

Headquarters

Date

7100-52-(3,68)

Sue Newstetter

Civil Eng Tech

SD

6/25/84

4

5

CORNER RECORD (PERPETUATION)

MONUMENT : DESCRIBE NEW MONUMENT SET, OR WORK DONE TO PRESERVE EXISTING MONUMENT

ACCESSORIES : DESCRIBE NEW BT'S WITNESS OBJECTS ETC. ESTABLISHED, OR WORK DONE TO PRESERVE EXISTING EVIDENCE

Work Done By _____ Title _____ Date _____ State Registration No. _____
or Agency _____
Certified Cor. Record Prepared ? Yes No Filed At: _____ Date _____

REMARKS

Index File No. T. R. M. Tract or Surv. No. Cor.