

Index File No. J-24

CORNER RECORD (SEARCH)
(Ref. FSM 7151.4)


Tract or Survey No. _____ Cor. No. _____

T 45 R. 30E

R.D. Ukiah County Umatilla

Merid. Willamette

N.F. Umatilla State Oregon

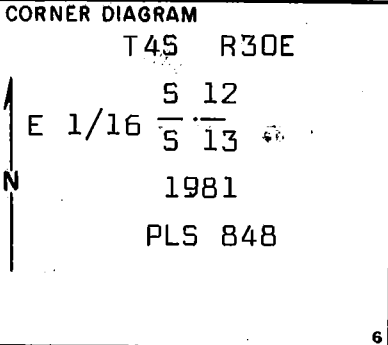

DESCRIBE CORNER MONUMENT FOUND

Corner not previously established.

DESCRIBE BEARING TREES OR OTHER OFFICIAL ACCESSORIES FOUND

N/A

PHOTO IDENTIFICATION DATA

Photo No. _____

Filed At. _____

Object Ident. _____

Ident. By _____

Signature

DESCRIBE CORNER LOCATION RELATIVE TO NEAR-BY FEATURES, ALSO HOW TO REACH CORNER

Corner on fir and pine timbered North slope approx. 250 ft. South from draw bottom.

PLANE COORDINATE POSITION DATA

State _____ Zone _____

X _____

Y _____

Estab. By _____

Agency

Signature

Title _____ Division _____ Headquarters _____ Date _____

PLS 848, Mt. Vernon, OR 8/5/81

CORNER RECORD (PERPETUATION)

MONUMENT: DESCRIBE NEW MONUMENT SET, OR WORK DONE TO PRESERVE EXISTING MONUMENT

Set 3"x30" galv. iron pipe with 3" brass cap stamped as shown on the diagram. Set pipe 26 inches in the ground.

From which:

ACCESSORIES: DESCRIBE NEW BT'S WITNESS OBJECTS ETC. ESTABLISHED, OR WORK DONE TO PRESERVE EXISTING EVIDENCE

A fir 18 inches dia. bears N54°E, 30.0 ft. scribed E 1/16 S 12 BT.
A fir 9 inches dia. bears S 56°W, 4.5 ft. scribed E 1/16 S 13 BT.
Set steel posts with warning and boundary signs 5 ft. North and 5 ft. South from corner.
Nailed bearing tree signs and brass washers stamped PLS 848 to each tree.

Work Done By D.M. Ferguson Title Surveyor Date 8/5/81 State Registration No. OR PLS 848
or Agency

Certified Copy Record Prepared? Yes No Filed At: Umatilla Co. Surveyor Off Date

REGISTERED
**PROFESSIONAL
LAND SURVEYOR**

REMARKS

Witnesses to above corner:
D. Mitchell Ferguson
Mike Woodward

Douglas M. Ferguson
OREGON
JULY 12, 1968
DOUGLAS M. FERGUSON
848