

USDA-FOREST SERVICE

Index

File No. ~~XXXXXX~~ L-21

CORNER RECORD (SEARCH)

(Ref. FSM 7151.4)

Tract or

Survey No. _____

Corr.

No. _____

T 4S R. 30E

R.D. UKIAH

County UMATILLA


Merid. WILL.

N.F. UMATILLA

State OREGON

CORNER DIAGRAM

T4S R30E

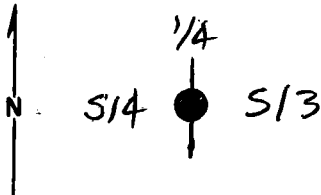

DESCRIBE CORNER MONUMENT FOUND

ORIGINAL CORNER STONE MARKED "1/4" ON WEST FACE

DESCRIBE BEARING TREES OR OTHER OFFICIAL ACCESSORIES FOUND

26" PINE STUMP S15°E 22.6' MKD "BT"
39" PINE STUMP S12°W 29.6' MKD "SBT"

PHOTO IDENTIFICATION DATA

Photo No. _____

Filed At. _____

Object Ident. _____

Ident. By _____

Signature

PLANE COORDINATE POSITION DATA

State _____ Zone _____

X _____

Y _____

Estab. By _____

Agency

Signature

Title

Division

Headquarters

Date

7100-52-(3-68)

Dennis L. Gaylord

PLS 1636

1-19-81

2

3

4

5

CORNER RECORD (PERPETUATION)

MONUMENT: DESCRIBE NEW MONUMENT SET, OR WORK DONE TO PRESERVE EXISTING MONUMENT

2 1/2" x 30" IRON PIPE W/ 3" BRASS CAP MKD: TAS R30E
1/4
S14 | S13
PLS 1636

ACCESSORIES: DESCRIBE NEW BT'S WITNESS OBJECTS ETC. ESTABLISHED, OR WORK DONE TO PRESERVE EXISTING EVIDENCE

13" POND, PINE S29°E 30² ft SCRIBED "1/4 S13 BT"
11" DOUG FIR N34°30'W 21² ft. SCRIBED "1/4 S14 BT"

Work Done By Dennis P. Taylor Title _____ Date 1-19-81 State Registration No. PLS 1636
or Agency _____
Certified Cor. Record Prepared Yes No Filed At: ematilla Co. Date 1-26-81

REMARKS

Index File No. T. R. M. Tract or Surv. No. Cor. 12
L-21 4S 30E WILL 13


Index
 File No. L-21
 T 4 S. R. 30 E.
 Merid. Willamette

CORNER RECORD (SEARCH)
 (Ref. FSM 7151.4)

Tract or
 Survey No. Cor.
 No.

R.D. Ukiah County Umatilla
 N.F. Umatilla State Oregon

CORNER DIAGRAM

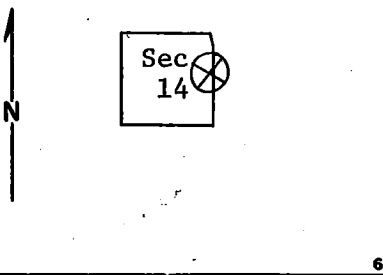

DESCRIBE CORNER MONUMENT FOUND

Basalt stone, 14"x12"x4", 10" above ground, fair condition.
 Marking not clear. Sets in circle of smaller stones.

DESCRIBE BEARING TREES OR OTHER OFFICIAL ACCESSORIES FOUND

A 24" p.pine stump, 30" high, bears S.15°E., approx. 15 ft. Scribing visible. A 38" p.pine stump, 30" high, bears S.12°W., approx. 20'. Scribing visible (GLO notes say S.12°E. No doubt this is erroneous since other B.T. was S.E.) Both B.T.'s have been logged and stumps are very rotten. An old location poster on an 8" Doug-fir bears N30°W. approx. 20'.

PHOTO IDENTIFICATION DATA

Photo No.
 Filed At.
 Object Ident.
 Ident. By
Signature

DESCRIBE CORNER LOCATION RELATIVE TO NEAR-BY FEATURES, ALSO HOW TO REACH CORNER

1/4 corner is about 450 ft. south of a primitive road. It is also about 400 ft. west of an old well. The well sets in lower edge of an open area in the vicinity of some old sheds.

PLANE COORDINATE POSITION DATA

State Zone
 X
 Y
 Estab. By
Agency

Signature T. Hollamon Title Eng, Tech, Division Headquarters S.O, Date 5/31/74 7100-52-(3/68)

2

3

4

5

CORNER RECORD (PERPETUATION)

MONUMENT: DESCRIBE NEW MONUMENT SET, OR WORK DONE TO PRESERVE EXISTING MONUMENT

ACCESSORIES : DESCRIBE NEW BT'S WITNESS OBJECTS ETC. ESTABLISHED, OR WORK DONE TO PRESERVE EXISTING EVIDENCE

I placed blank B.T. tags on the two B.T. stumps. Also placed a location poster on a 22" p. pine at south edge of a primitive road approx. 450 ft. north.

Work Done By _____ Title _____ Date _____ State Registration No. or Agency _____

Certified Cor. Record Prepared ? Yes No Filed At: _____ Date _____

REMARKS

Index File No. T. R. M. Tract or Surv. No. Cor.