

USDA-FOREST SERVICE

Index
File No. A-25

CORNER RECORD (SEARCH)
(Ref. FSM 7151.4)

Tract or
Survey No. _____
Cor. No. A-25


T 4S R. 31E

R.D. Ukiah County Umatilla

Merid. Willamette

N.F. Umatilla State Oregon

CORNER DIAGRAM

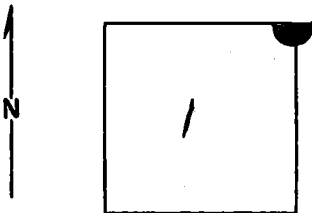

DESCRIBE CORNER MONUMENT FOUND

~~CR: 74S, R32E A 1~~
Brass Cap! see Monumentation F. 10

DESCRIBE BEARING TREES OR OTHER OFFICIAL ACCESSORIES FOUND

PHOTO IDENTIFICATION DATA

Photo No. _____
Filed At. _____
Object Ident. _____
Ident. By _____
Signature

DESCRIBE CORNER LOCATION RELATIVE TO NEAR-BY FEATURES, ALSO HOW TO REACH CORNER

PLANE COORDINATE POSITION DATA

State _____ Zone _____
X _____
Y _____
Estab. By _____
Agency

Signature

Title

Division

Headquarters

Date

7100-52-(3/68)

CORNER RECORD (PERPETUATION)

GPO 902-673

MONUMENT : DESCRIBE NEW MONUMENT SET, OR WORK DONE TO PRESERVE EXISTING MONUMENT

9

ACCESSORIES : DESCRIBE NEW BT's WITNESS OBJECTS ETC. ESTABLISHED, OR WORK DONE TO PRESERVE EXISTING EVIDENCE

10

Work Done By _____ Title _____ Date _____ State Registration No. or Agency _____

Certified Cor. Record Prepared ? Yes No Filed At: _____ Date _____

11

REMARKS

12

Index File No. T. R. M. Tract or Surv. No. Cor. 13

USDA-FOREST SERVICE

Index File No. A-1

CORNER RECORD (SEARCH)

(Ref. FSM 7151.4)

Tract or Survey No. _____ Cor. No. CC


T 4S R. 32E

R.D. Ukiah County Umatilla

Merid. W.M.

N.F. Umatilla State Oregon

CORNER DIAGRAM

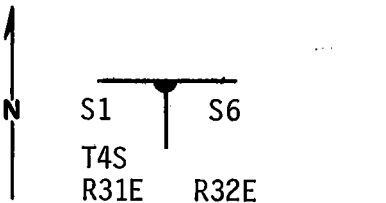

DESCRIBE CORNER MONUMENT FOUND

No trace of wood post found.

2

DESCRIBE BEARING TREES OR OTHER OFFICIAL ACCESSORIES FOUND

Old BT stump with good scribing and 54-3 tag found. It is rotten at the bottom and loose. 8" in dia. From this position corner is N42°E, 17.2 feet. No trace of other BT.

3

DESCRIBE CORNER LOCATION RELATIVE TO NEAR-BY FEATURES, ALSO HOW TO REACH CORNER

Near east and south bearing fence corner and about 250' west of main road.

4

PHOTO IDENTIFICATION DATA

Photo No. _____
 Filed At. _____
 Object Ident. _____
 Ident. By _____
 Signature _____

6

PLANE COORDINATE POSITION DATA

State _____ Zone _____
 X _____
 Y _____
 Estab. By _____
 Agency _____

8

Signature Barry B. Barbour

Title P.L.S.

Division _____

Headquarters _____

Date 11/8/77

7100-52-(3/68)

5

CORNER RECORD (PERPETUATION)

MONUMENT: DESCRIBE NEW MONUMENT SET, OR WORK DONE TO PRESERVE EXISTING MONUMENT

At point where north bearing line intersects the Township line,
set 2½"x30" galvanized pipe with brass cap marked:
Set pipe 26" in the ground. Corner is 1.49' south and 0.01' east
of old position from BT.

OR: PLS 1051

T3S R31E

S1 S6

CC

T4S R31E/R32E

1977

9

ACCESSORIES : DESCRIBE NEW BT'S WITNESS OBJECTS ETC. ESTABLISHED, OR WORK DONE TO PRESERVE EXISTING EVIDENCE

New BT's: A fir 12" in dia, bears S30⁰E, 18.7 feet scribed T4S R32E S6 BT.
A fir 12" in dia, bears S84⁰W, 8.7 feet, scribed T4S R31E S1 BT. Placed 54-3s
and 54-4s on BT's, brass washer on BT blaze, stamped PLS 1051. Placed 54-2s
and 54-4s on fence post 5' south and 4' east of corner. Painted 6" red
bands and both blazes red.

10

Work Done By B.B. Barbour Title P.L.S. Date 11/8/77 State Registration No. OR PLS 1051
or Agency

Certified Cor. Record Prepared? Yes No Filed At: Date

11

REMARKS

Witnesses to corner: D.L. Landers
S. Nelson

12

Index File No. T. R. M. Tract or Surv. No. Cor.

13