

OREGON CORNER RESTORATION FORM

Section 16 Township 4S Range 31E
 County Umatilla Date: August 11, 2009

Corner Designation: 4S31N11

Quarter corner common to sections 16 and 21, T4S, R31E,
 W.M., Umatilla County, Oregon.



Condition Report Only
 Not found
 Remonumented
 Unrecorded
 Surveyed in
 Referenced out

Previous Renewals / Surveys, etc.

Corner originally set by George S. Pershin under contract No. 373 dated September 17, 1880. His record reads: Set basalt stone 26 x 14 x 10 on N.E. slope in mound of stone for 1/4 sec. cor.

Monument and Accessories found: (condition and source)

The original stone, lightly but plainly marked 1/4, firmly in place at the south edge of a mound of stone about 8 feet in diamter. The majority of the stone mound appeared to be an old rock jack and had some old fence wire protruding from it.

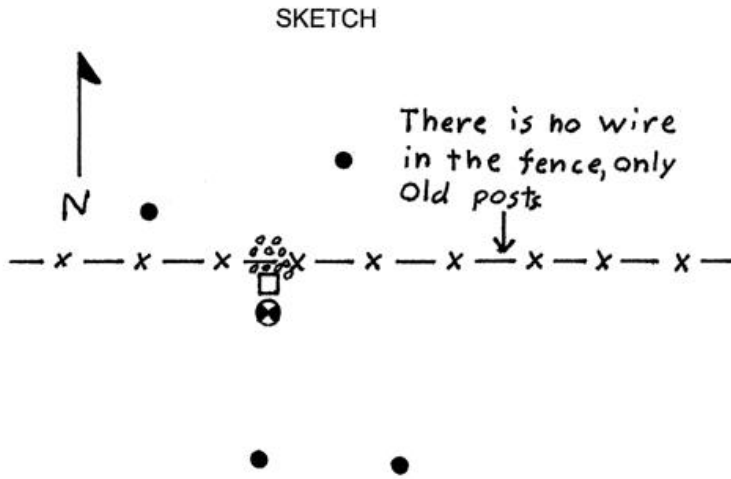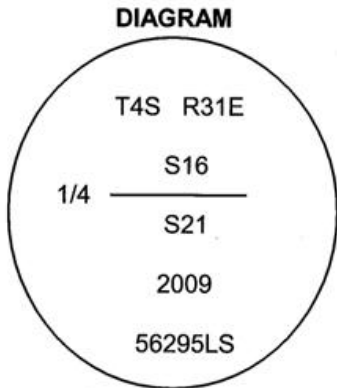

- ⊗ = Brass Cap
- = Rebar Reference
- = Steel post w/sign

MONUMENT (S) AND ACCESSORIES SET (Procedures and Description)

At the corner point I set a 2 3/8" brass cap on a 1 1/2" x 30" galvanized iron pipe 26" in the ground to bedrock. I buried the original stone along the pipe on the north side and made a small collar of stone around the cap. I stamped the cap as shown in the diagram above.

For references, I set four 5/8" by 24" rebars with 1.25" orange plastic caps stamped WTS and 56295LS as described below:

- an iron rebar bears N45°48'09"W, 147.40 feet;
- an iron rebar bears N17°51'21"E, 124.77 feet;
- an iron rebar bears S52°47'49"E, 49.41 feet;
- an iron rebar bears S6°30'40"W, 54.65 feet;

The monument and references were tied using a Trimble R7/R8 RTK GPS.

Location and comments

Witnessed By:
 Jacob Fitzgerald

RECEIVED BY:
Umatilla County Surveyor
 Date: 9-09
 Rec'd By: KK
 No. 09-123-B

Compass Declination

Firm / Agency
 Witness Tree Surveying
 Address
 P.O. Box G
 Pilot Rock, Or. 97868
 Party Chief
 Stephen K, Haddock

Surveyors Seal

REGISTERED
 PROFESSIONAL
 LAND SURVEYOR

Stephen K. Haddock

OREGON
 JULY 9, 2001
 STEPHEN K. HADDOCK
 56295LS

RENEWAL DATE 6-30-11