

OREGON CORNER RESTORATION FORM

Section 17 Township 4S Range 31E
 County Umatilla Date: August 11, 2009

Corner Designation: 4S31N7

Quarter corner common to sections 17 and 20, T4S, R31E,
 W.M., Umatilla County, Oregon.


Condition Report Only
 Not found
 Remonumented
 Unrecorded
 Surveyed in
 Referenced out

Previous Renewals / Surveys, etc.


Corner originally set by George S. Pershin under contract No. 373 dated September 17, 1880. His record reads: Set basalt stone 16 x 14 x 8 on S.E. slope for 1/4 sec. cor. A pine, 12 ins. diam. brs. S. 54° W. 121 lks. dist. No trees north.

Monument and Accessories found: (condition and source)

The original stone, spalling, with possible chisel marks, in a small mound of stone at near record bearing and distance from the bearing tree stump. The stump has no visible scribing but is the only stump in the area.

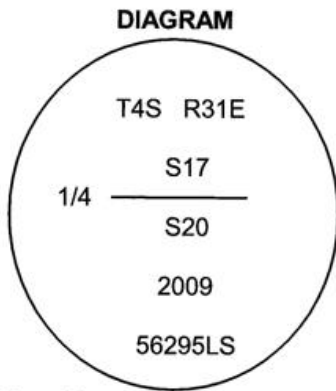

- = Brass Cap
- = Rebar Reference
- = Guard Post w/sign

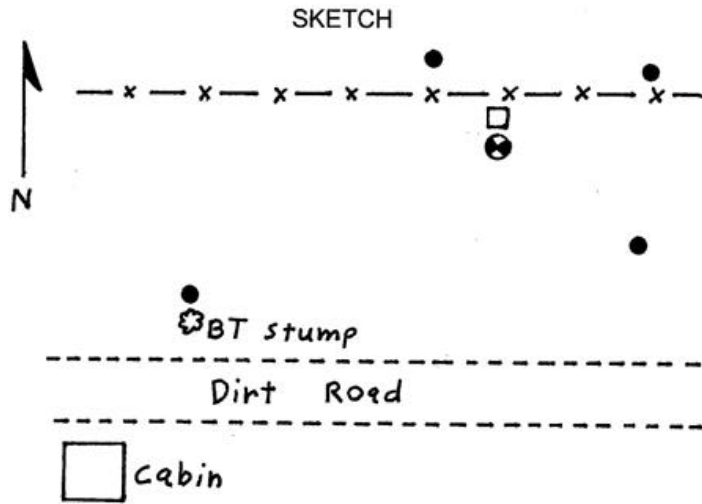

MONUMENT (S) AND ACCESSORIES SET (Procedures and Description)

At the corner point I set a 2 3/8" brass cap on a 1 1/2" x 30" galvanized iron pipe 22" in the ground to bedrock and buried the original stone along side. I built a mound of stone approximately 3' diameter to the top of the cap. I stamped the cap as shown in the diagram above.

For references, I set four 5/8" by 24" rebars with 1.25" orange plastic caps stamped WTS and 56295LS as described below:

- an iron rebar bears N55°34'12"W, 53.18 feet;
- an iron rebar bears N29°27'14"E, 46.51 feet;
- an iron rebar bears S76°28'14"E, 55.51 feet;
- an iron rebar bears S55°12'01"W, 77.37 feet in the roots of the original bearing tree stump;
- the original bearing tree stump bears S54°51"W 78.0 feet;

The monument and references were tied using a Trimble R7/R8 RTK GPS.

Location and comments

Witnessed By:
 Jacob Fitzgerald

RECEIVED BY:
 Umatilla County Surveyor
 Date: 9-09
 Rec'd By: KE
 No. 09-123-B

Compass Declination

Firm / Agency
 Witness Tree Surveying
 Address
 P.O. Box G
 Pilot Rock, Or. 97868
 Party Chief
 Stephen K, Haddock

Surveyors Seal

REGISTERED
 PROFESSIONAL
 LAND SURVEYOR

Stephen K. Haddock

OREGON
 JULY 9, 2001
 STEPHEN K. HADDOCK
 56295LS

RENEWAL DATE 6-30-11