

USDA-FOREST SERVICE

Index  
File No. F-3

CORNER RECORD (SEARCH)


(Ref. FSM 7151.4)

Tract or  
Survey No. \_\_\_\_\_  
Gor. No. CN1/16

T 4S R. 32E R.D. Ukiah County Umatilla

Merid. W.M. N.F. Umatilla State Oregon

CORNER DIAGRAM

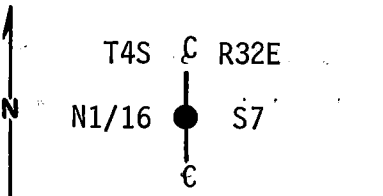

DESCRIBE CORNER MONUMENT FOUND

None set.

DESCRIBE BEARING TREES OR OTHER OFFICIAL ACCESSORIES FOUND

None set.

PHOTO IDENTIFICATION DATA

Photo No. \_\_\_\_\_  
Filed At. \_\_\_\_\_  
Object Ident. \_\_\_\_\_  
Ident. By \_\_\_\_\_  
*Signature*

DESCRIBE CORNER LOCATION RELATIVE TO NEAR-BY FEATURES, ALSO HOW TO REACH CORNER

Corner falls on the east edge of small drain.

PLANE COORDINATE POSITION DATA

State \_\_\_\_\_ Zone \_\_\_\_\_  
X \_\_\_\_\_  
Y \_\_\_\_\_  
Estab. By \_\_\_\_\_  
*Agency*

*Signature*  
*Barry B. Barber*

Title P.L.S. Division \_\_\_\_\_ Headquarters \_\_\_\_\_ Date 11/16/77 7100-52-(3/68)

2

3

4

5

**CORNER RECORD (PERPETUATION)**

GPO 902-673

**MONUMENT: DESCRIBE NEW MONUMENT SET, OR WORK DONE TO PRESERVE EXISTING MONUMENT**

Set 2 1/2"x30" galvanized pipe with brass cap marked:  
Set pipe 18" in the ground to bedrock and mound of stone around.

T4S R32E  
N1/16 S7  
OR PLS 1051  
1977

**ACCESSORIES: DESCRIBE NEW BT'S, WITNESS OBJECTS ETC. ESTABLISHED, OR WORK DONE TO PRESERVE EXISTING EVIDENCE**

From which: A fir 16" in dia. bears S20°E, 38.3 ft., scribed N1/16 S7 BT. A fir 9" in dia. bears S44°W, 41.8 ft., scribed N1/16 S7 BT. Placed brass washer stamped PLS 1051 on foot blazes. Placed 54-3s and 54-4s on BT's. Placed 54-2, 54-4 and 54-9 on fence post 4' west of corner. Placed 54-2 on 4" pine, 2 ft., east of corner. Painted 6" red band around BT's and painted both blazes red.

Work Done By B.B. Barbour Title P.L.S. Date 11/16/77 State Registration No. OR PLS 1051  
or Agency

Certified Cor. Record Prepared ? Yes  No  Filed At: \_\_\_\_\_ Date \_\_\_\_\_

**REMARKS**

Witness to the above: L. Clemens