

USDA-FOREST SERVICE

Index
File No. G-10


CORNER RECORD (SEARCH)

(Ref. FSM 7151.4)

Tract or Survey No. _____ Cor. No. CW1/16

T 4S R. 32E R.D. Ukiah County Umatilla
Merid. W.M. N.F. Umatilla State Oregon

CORNER DIAGRAM

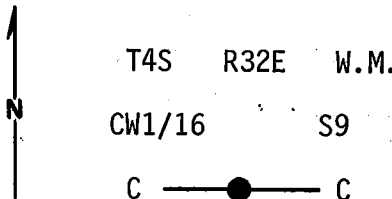

DESCRIBE CORNER-MONUMENT FOUND

None set.

DESCRIBE BEARING TREES OR OTHER OFFICIAL ACCESSORIES FOUND

None set.

PHOTO IDENTIFICATION DATA

Photo No. _____
Filed At. _____
Object Ident. _____
Ident. By _____
Signature

DESCRIBE CORNER LOCATION RELATIVE TO NEAR-BY FEATURES, ALSO HOW TO REACH CORNER

The corner lies on a slight westerly slope about 150 feet west of a lightly traveled road.

PLANE COORDINATE POSITION DATA

State _____ Zone _____
X _____
Y _____
Estab. By _____
Agency

Barney B. Barbour

Title
P.L.S.

Division

Headquarters

Date
10/25/77

7100-52-(3/68)

CORNER RECORD (PERPETUATION)

MONUMENT: DESCRIBE NEW MONUMENT SET, OR WORK DONE TO PRESERVE EXISTING MONUMENT

Set 2 1/2"x30" galvanized pipe with brass cap marked:
Set pipe 24" in the ground and built a mound of stone to cap.

T4S R32E
CW1/16 S9
C — + — C
1977
OR PLS 1051

9

ACCESSORIES : DESCRIBE NEW BT'S WITNESS OBJECTS ETC. ESTABLISHED, OR WORK DONE TO PRESERVE EXISTING EVIDENCE

A pine 13" in dia. bears N37⁰W, 10.4 ft., scribed CW1/16 S9 BT. A pine 10" in dia. bears S44⁰E, 7.7 ft., scribed CW1/16 S9 BT. Attached brass washer, stamped PLS 1051, to the foot blaze of each B.T. Attached a 54-3 and a 54-4 sign to each B.T. Set a painted metal fence post 4 ft. south of the monument with 54-2 and a 54-9 sign attached. Set another post 3 ft. east of the monument with a 54-2 and a 54-4 sign attached. Painted a 6" band around each B.T. and both blazes on each B.T. red.

10

Work Done By R. C. Orton Title Party Chief Date 11/9/77 State Registration No. or Agency _____

Certified Cor. Record Prepared ? Yes No Filed At: _____ Date _____ 11

REMARKS

Witnesses to the above: G. Wagoner, L. Clemens

12

Index File No. T. R. M. Tract or Surv. No. Cor. 13