

USDA-FOREST SERVICE

Index
File No. G-14

CORNER RECORD (SEARCH)

(Ref. FSM 7151.4)

Tract or Survey No. SECTION 10 Cor. No. CW 4/6


T 45 R. 32E

R.D. UKIAH County UMATILLA

Merid. WILLAMETTE

N.F. UMATILLA State OREGON

CORNER DIAGRAM

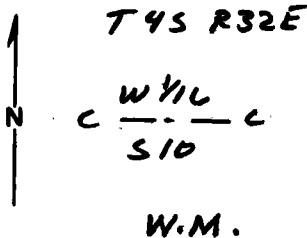

DESCRIBE CORNER MONUMENT FOUND

FOUND 2" G.I.P. W/ A 2 1/2" BRASS CAP EXPOSED 10"

DESCRIBE BEARING TREES OR OTHER OFFICIAL ACCESSORIES FOUND

FIR 10" DIA. BRS. S86°33'W 53.8 FT. } OF WHICH I
FIR 12" DIA. BRS. N5°36'W 8.9 FT. } HAVE NO RECORD.

PHOTO IDENTIFICATION DATA

Photo No. _____
Filed At. _____
Object Ident. _____
Ident. By _____
Signature _____

DESCRIBE CORNER LOCATION RELATIVE TO NEAR-BY FEATURES, ALSO HOW TO REACH CORNER

FROM ROAD XING NEAR 1/4 COR 9/10 WALK EAST ALONG POSTED LINE TO CORNER.

PLANE COORDINATE POSITION DATA

State _____ Zone _____
X _____
Y _____
Estab. By _____
Agency _____

Stationers Paul E. ... Title P.L.S.

Division _____ Headquarters _____

Date 1/9/81 7100-52 (3-68)

CORNER RECORD (PERPETUATION)

MONUMENT: DESCRIBE NEW MONUMENT SET, OR WORK DONE TO PRESERVE EXISTING MONUMENT

ACCESSORIES : DESCRIBE NEW BT'S WITNESS OBJECTS ETC. ESTABLISHED, OR WORK DONE TO PRESERVE EXISTING EVIDENCE

Work Done By K.C. WEAVER Title PLS Date 1/9/81 State Registration No. LS. 1679
or Agency

Certified Cor. Record Prepared? Yes No Filed At: _____ Date _____

REMARKS

Index File No. T. R. M. Tract or Surv. No. Cor.

Index
File No. G-14
T 4S R. 32E
Merid. Willamette


CORNER RECORD (SEARCH)

(Ref. FSM 7151.4)

R.D. Ukiah County Umatilla
N.F. Umatilla State Oregon

Tract or
Survey No. _____
Cor. No. CW 1/16

CORNER DIAGRAM

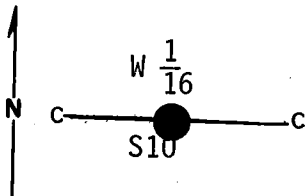

DESCRIBE CORNER MONUMENT FOUND

None set.

DESCRIBE BEARING TREES OR OTHER OFFICIAL ACCESSORIES FOUND

PHOTO IDENTIFICATION DATA

Photo No. _____
Filed At. _____
Object Ident. _____
Ident. By _____
Signature

PLANE COORDINATE POSITION DATA

State _____ Zone _____
X _____
Y _____
Estab. By _____
Agency

DESCRIBE CORNER LOCATION RELATIVE TO NEAR-BY FEATURES, ALSO HOW TO REACH CORNER

Corner falls on fairly steep north slope 240 ft. north of large clearing on level ground.

Signature

Title

Division
ORLS

Headquarters
1294

Date
9/77

7100-52 (3. 68)

CORNER RECORD (PERPETUATION)

MONUMENT : DESCRIBE NEW MONUMENT SET, OR WORK DONE TO PRESERVE EXISTING MONUMENT

New Corner:

T4S R32E
CW 1/16 S10

At surveyed point: Set 2½"x30" galvanized pipe with brass cap marked:

C ———— + ———— C
1977
OR PLS 1051

ACCESSORIES : DESCRIBE NEW BT'S WITNESS OBJECTS ETC. ESTABLISHED, OR WORK DONE TO PRESERVE EXISTING EVIDENCE

A Fir 9" in diameter bears N89⁰E, 53.7 ft., scribed CW 1/16 S10 BT. A Fir 13" in diameter bears S02⁰W, 9.5 ft., scribed CW 1/16 S10 BT. Set pipe 22" in ground and built a mound of stones to the cap. Attached 54-3 and 54-4 signs to both BTs. Attached brass washer, stamped PLS 1051, to the foot blazes of both BTs. Painted a 6" band around the BTs and both blazes red. Set painted metal fence post 6 ft. south of corner with 54-2 and 54-9 signs attached. Set a painted metal fence post 5 ft. west of corner with 54-2 and 54-4 signs attached.

Work Done By R. C. Orton Title Party Chief Date 12/8/80 State Registration No. _____
or Agency _____

Certified Cor. Record Prepared ? Yes No _____ Filed At: _____ Date _____

REMARKS

Witnesses: G. Lester

Index File No. T. R. M. Tract or Surv. No. Cor. 12