

USDA-FOREST SERVICE

Index
 File No. H-2
 T 4S R. 32E
 Merid. W.M.


CORNER RECORD (SEARCH)

(Ref. FSM 7151.4)

Tract or
 Survey No. _____ Cor. No. SW1/16

R.D. Ukiah County Umatilla
 N.F. Umatilla State Oregon

CORNER DIAGRAM

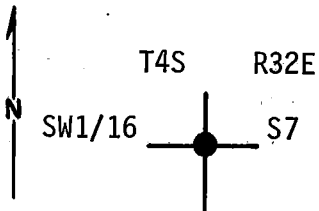

DESCRIBE CORNER MONUMENT FOUND

None set.

DESCRIBE BEARING TREES OR OTHER OFFICIAL ACCESSORIES FOUND

None set.

PHOTO IDENTIFICATION DATA

Photo No. _____
 Filed At. _____
 Object Ident. _____
 Ident. By _____

Signature

PLANE COORDINATE POSITION DATA

State _____ Zone _____
 X _____
 Y _____
 Estab. By _____

Agency

DESCRIBE CORNER LOCATION RELATIVE TO NEAR-BY FEATURES, ALSO HOW TO REACH CORNER

Corner is about 50 feet south of an east-west fence in an open area.

Signature

P.L.S.
 Title

Division

Headquarters

Date
 11/16/77

7100-52-(3/68)

Barney B. Barbour

CORNER RECORD (PERPETUATION)

GPO 902-673

MONUMENT: DESCRIBE NEW MONUMENT SET, OR WORK DONE TO PRESERVE EXISTING MONUMENT

Set 2½"x30" galvanized pipe with brass cap marked:
Set pipe 14" in the ground to bedrock and mound of stone around.

T4S R32E
SW1/16 S7
+
OR PLS 1051
1977

ACCESSORIES: DESCRIBE NEW BT'S WITNESS OBJECTS ETC. ESTABLISHED, OR WORK DONE TO PRESERVE EXISTING EVIDENCE

A pine 9" in dia. bears S02°W, 34.3 ft., scribed SW1/16, S7 BT. A pine 9" in dia. bears N70°W, 24.1 ft., scribed SW1/16, S7 BT. Placed 54-3s and 54-4s on both BTs. Placed brass washer stamped PLS 1051 on foot blazes. Placed 54-2, 54-4 and 54-9 on fence post 5' west of corner. Painted 6" red band around BTs and painted both blazes red.

Work Done By B.B. Barbour Title P.L.S. Date 11/16/77 State Registration No. OR PLS 1051
or Agency

Certified Cor. Record Prepared? Yes No Filed At: _____ Date _____

REMARKS

Witness to the above: Lyle Clemens