

USDA-FOREST SERVICE

Index
File No. J-10
T 4S R. 32E
Merid. Willamette

CORNER RECORD (SEARCH)

(Ref. FSM 7151.4)

Tract or Survey No. Sec 9 Cor. No. W 1/16

R.D. Ukiah County Umatilla
N.F. Umatilla State Oregon

CORNER DIAGRAM

T4S R32E



S-9 W 1/16

S-16

DESCRIBE CORNER MONUMENT FOUND

Found 2" GIP w/ 2 1/2" BC 1977 PLS 1051
Exp. 12" MOS

DESCRIBE BEARING TREES OR OTHER OFFICIAL ACCESSORIES FOUND

Pine 26" dia., Brs N 15° 54' W 72.0 FT
Pine 14" dia., Brs S 23° 04' W 89.6 FT

PHOTO IDENTIFICATION DATA

Photo No. _____
Filed At. _____
Object Ident. _____
Ident. By _____
Signature

PLANE COORDINATE POSITION DATA

State _____ Zone _____
X _____
Y _____
Estab. By _____
Agency

DESCRIBE CORNER LOCATION RELATIVE TO NEAR-BY FEATURES, ALSO HOW TO REACH CORNER

INTERSECTION Rd 5417 And 5417-020; SOUTH
Rd 5417-020 1.2 mi TO SOUTH LINE SEC 9;
DUE WEST 1850' W 1/16 9/16

Signature

Art Weaver P.L.S.

Title

Division

Headquarters

Date

12/1/80

7100-52 (3-68)

CORNER RECORD (PERPETUATION)

MONUMENT : DESCRIBE NEW MONUMENT SET, OR WORK DONE TO PRESERVE EXISTING MONUMENT

ACCESSORIES : DESCRIBE NEW BT'S WITNESS OBJECTS ETC. ESTABLISHED, OR WORK DONE TO PRESERVE EXISTING EVIDENCE

Work Done By KA. Weaver Title PLS Date 12/11/00 State Registration No. 1679
or Agency

Certified Cor. Record Prepared ? Yes No X Filed At: _____ Date _____

REMARKS

Index File No. T. R. M. Tract or Surv. No. Cor.


USDA-FOREST SERVICE

Index
 File No. J-10
 T 4S. R. 32E
 Merid. W.M.

CORNER RECORD (SEARCH)
 (Ref. FSM 7151.4)

Tract or Survey No. _____
 Cer. No. W1/16
 R.D. Ukiah County Umatilla
 N.F. Umatilla State Oregon

CORNER DIAGRAM

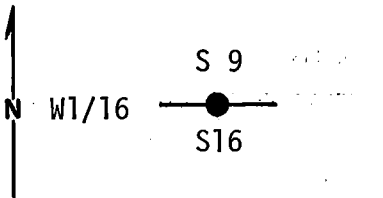

DESCRIBE CORNER MONUMENT FOUND

None Set.

DESCRIBE BEARING TREES OR OTHER OFFICIAL ACCESSORIES FOUND

None Set.

PHOTO IDENTIFICATION DATA

Photo No. _____
 Filed At. _____
 Object Ident. _____
 Ident. By _____
Signature

DESCRIBE CORNER LOCATION RELATIVE TO NEAR-BY FEATURES, ALSO HOW TO REACH CORNER

The corner is on a southeast slope. About 300 feet west from the bottom of a draw. Lies on the south side of the east-west fence.

PLANE COORDINATE POSITION DATA

State _____ Zone _____
 X _____
 Y _____
 Estab. By _____
Agency

Barry B. Barbour
 Signature

Title P.L.S. Division _____ Headquarters _____ Date 11/2/77
 7100-52-(3/68)

CORNER RECORD (PERPETUATION)

GPO 902-673

MONUMENT: DESCRIBE NEW MONUMENT SET, OR WORK DONE TO PRESERVE EXISTING MONUMENT

Set 2½"x30" galvanized pipe with brass cap marked:
 Set pipe 24" in ground and built a mound of stone to the cap.

T4S R32E
 S 9
 ————
 W 1/16 S 16
 1977
 OR PLS 1051

ACCESSORIES: DESCRIBE NEW BT'S WITNESS OBJECTS ETC. ESTABLISHED, OR WORK DONE TO PRESERVE EXISTING EVIDENCE

A Pine 23" in dia. bears N13°W, 72.0 ft., scribed W1/16 S9 BT.
 A Pine 12" in dia. bears S24°W, 89.6 ft., scribed W 1/16 S16 BT. Attached brass washer, stamped PLS 1051 to the foot blaze of each BT. Attached a 54-3 and a 54-4 sign to each BT. Set a painted metal fence post 5 ft. north of monument with a 54-2 and a 54-9 sign attached. Set another post 5 ft. east of monument with a 54-2 and a 54-4 sign attached. Painted a 6" band around each BT and both blazes on each BT red.

Work Done By R. C. Orton Title Party Chief Date 11/2/77 State Registration No. or Agency _____

Certified Cor. Record Prepared? Yes No Filed At: _____ Date _____

REMARKS

Witnesses: G. Wagoner
 L. Clemens