

USDA-FOREST SERVICE


Index  
 File No. J-6  
 T 4S R. 32E  
 Merid. W.M.

CORNER RECORD (SEARCH)

(Ref. FSM 7151.4)

Tract or Survey No. \_\_\_\_\_ Cor. No. W1/16  
 R.D. Ukiah County Umatilla  
 N.F. Umatilla State Oregon

CORNER DIAGRAM

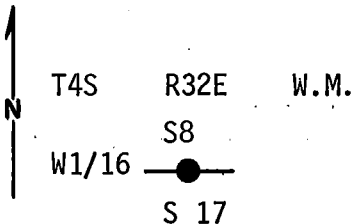

DESCRIBE CORNER MONUMENT FOUND

None set.

DESCRIBE BEARING TREES OR OTHER OFFICIAL ACCESSORIES FOUND

None set.

PHOTO IDENTIFICATION DATA

Photo No. \_\_\_\_\_  
 Filed At. \_\_\_\_\_  
 Object Ident. \_\_\_\_\_  
 Ident. By \_\_\_\_\_  
 Signature \_\_\_\_\_

DESCRIBE CORNER LOCATION RELATIVE TO NEAR-BY FEATURES, ALSO HOW TO REACH CORNER

The corner is on a southwest slope about 200 feet east of the bottom of a draw.

PLANE COORDINATE POSITION DATA

State \_\_\_\_\_ Zone \_\_\_\_\_  
 X \_\_\_\_\_  
 Y \_\_\_\_\_  
 Estab. By \_\_\_\_\_  
 Agency \_\_\_\_\_

Signature

*Barry B. Barbour*

Title  
 P, L, S.

Division

Headquarters

Date

11/10/77

7100-52-(3/68)

5

**CORNER RECORD (PERPETUATION)**

GPO 902-673

**MONUMENT : DESCRIBE NEW MONUMENT SET, OR WORK DONE TO PRESERVE EXISTING MONUMENT**

Set 2½"x30" galvanized pipe with brass cap marked:  
 Set pipe 20" in ground **and built a mound of stone** to the cap.

T4S      R32E  
                   S8  
 W1/16 ———+———  
                   S17  
                   1977  
 OR PLS 1051

**ACCESSORIES : DESCRIBE NEW BT'S WITNESS OBJECTS ETC. ESTABLISHED, OR WORK DONE TO PRESERVE EXISTING EVIDENCE**

A pine 9" in dia. bears N13<sup>0</sup>E, 19.5 ft., scribed W1/16 S8 BT. A fir 11" in dia. bears S14<sup>0</sup>W, 30.7 ft., scribed W1/16 S17 BT. Attached brass washer, stamped PLS 1051, to the foot blaze of each B.T. Attached a 54-3 and a 54-4 sign to each B.T. Set a metal fence post 4 ft. north of the monument with a 54-2 and a 54-4 sign attached. Set another post 6 ft. south of the monument with a 54-2 and a 54-9 sign attached. Painted a 6" band around each B.T. and both blazes on each B.T. red.

Work Done By R.C. Orton Title Party Chief Date 11/10/77 State Registration No.                     
 or Agency                   

Certified Cor. Record Prepared ? Yes    No    Filed At:                    Date                   

**REMARKS**

Witnesses to the above: G. Wagoner, L. Clemens

Index File No.            T.                      R.                      M.                      Tract or Surv. No.                      Cor.                      12  
 13