


RECORD OF LAND CORNER MONUMENTATION

NORTH SIXTEENTH CORNER OF SECTIONS 17 AND 18, T. 4 S., R. 32 E., W.M.

ORIGINALLY ESTABLISHED BY:

Not previously established.

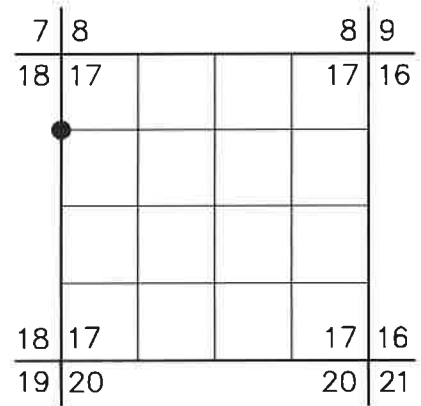

ORIGINAL DESCRIPTION:

Not previously established.

EVIDENCE FOUND:

Found a BLM K-tag marking the approximate location on a metal fence post, 4 ft. south of corner position determined by survey.

DESCRIPTION OF MONUMENTS AND ACCESSORIES SET AND METHODS USED:

Set standard USFS 2½"x30" aluminum pipe with ¾" aluminum cap, 22" in the ground in a collar of stone with 1 ft. diameter and placed a gray magnet at the base of monument. Cap is marked as shown in diagram.

From which, **I SCRIBE NEW BEARING TREES:**

- ▶ A douglas fir, 8" dbh, bears N.40°E., 6.2 ft., scribed *N1/16S17*.
- ▶ A tamarack, 8" dbh, bears S.51°E., 18.9 ft., scribed X in the upper blaze and *BT* in the lower blaze.

CORNER MONUMENT MARKED:



Painted a 6" red band around each bearing tree, and also painted blazes red and attached USFS 54-3 and 54-9 signs. Distances measured with a steel tape to a 60d nail driven in the right-side-center above the root crown, with a 1½" aluminum washer stamped PLS 91693. Bearings measured with a handheld compass with 14° east declination. Set aluminum posts, 3 ft. north and 5 ft. east with USFS 54-9 and 54-2 signs attached. Monument lies 5 ft. west of a north-south fence-line.

RESTORATION BY, STAMP AND DATE:


Work performed June 11, 2024 by:

T. DeJesus Quinones, LSIT

USDA FOREST SERVICE
 NORTHEAST OREGON LAND ZONE
 1550 Dewey Avenue, Suite A
 Baker City, OR 97814
 (541) 523-1281



T. DeJesus Quinones

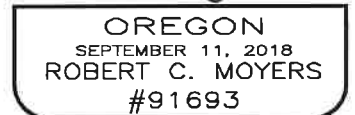

RENEWS: 12/31/2024

24-077-8