


# RECORD OF LAND CORNER MONUMENTATION

NORTH SIXTEENTH CORNER OF SECTION 17, T. 4 S., R. 32 E., W.M.

**ORIGINALLY ESTABLISHED BY:** Barry B Barbour, PLS 1051

**SURVEY NUMBER:** O-67-A

**SURVEY PERFORMED:** October - December, 1977

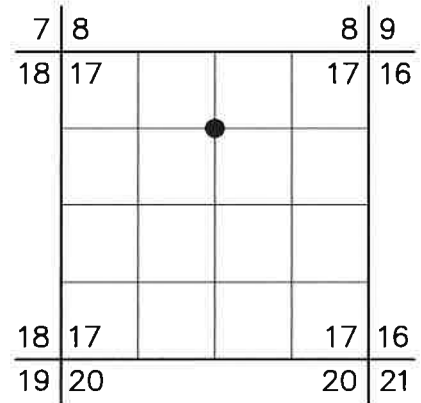

**ORIGINAL DESCRIPTION:**

Set 2½" x 30" galvanized pipe with brass cap marked (diagram shown):  
Set pipe 6" in the ground to bedrock and mound of stone around to cap.

From which:

- A pine 16" in dia. bears N50°E, 12.8' scribed N1/16 S17 BT.
- A pine 14" in dia. bears S82°W, 58.8' scribed N1/16 S17 BT.

Corner falls about 100 feet east of a track road and 20 feet south and west of fence corner.

Placed 54-3s, and 54-4s and brass washers stamped PLS 1051 on BT blazes. Painted blazes red and 6" red band around BT's. Placed 54-2 and 54-4 on fence post 6' each of corner. Placed 54-2 and 54-9 on fence post 5' south of corner.

**EVIDENCE FOUND:**

Found a 2½" galvanized iron pipe with a 2½" brass cap, marked as shown on the diagram, projecting 23" above ground in loose mound of stone with 4 ft. base. A steel gate post set in concrete, with fence lines extending west and south, is 2 ft. east and approximately 250 ft. east of Forest Service Road # 5412-130.

From which the original bearing trees:

- A ponderosa pine, bears N.50°E., 12.8 ft., searched for, not found.
- A ponderosa pine, 19" dbh, bears S.82°W., 58.8 ft., with a healed blaze in good condition.


**DESCRIPTION OF MONUMENTS AND ACCESSORIES SET AND METHODS USED:**

I accept the position of the found monument, and rebuild the mound of stone, with a 4 ft. base and 17" tall.

From which, I SET NEW REFERENCE MONUMENTS:

- ▶ A 5/8" x 12" iron rod driven to refusal, bears N.47°E., 9.03 ft., with attached 2" aluminum cap marked *RM 1 2024 PLS 91693*.

CORNER MONUMENT MARKED:

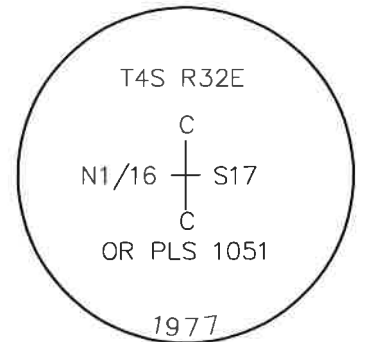

Painted a 6" red band around bearing tree, and also painted blaze red and attached USFS 54-3 and 54-9 signs as needed. Distance to bearing tree measured with handheld EDM to right-side-center. Distance to reference monument measured with steel tape. Bearings measured with a handheld compass with 14° east declination. Set an aluminum post with USFS 54-2 and 54-9 signs, 4 ft. east from monument.

**RESTORATION BY, STAMP AND DATE:**

Work performed June 26, 2024 by:

T. DeJesus Quinones, LSIT

USDA FOREST SERVICE  
NORTHEAST OREGON LAND ZONE  
1550 Dewey Avenue, Suite A  
Baker City, OR 97814  
(541) 523-1281



RENEWS: 12/31/2024

24-077-6