

USDA FOREST SERVICE

CORNER RECORD (SEARCH)

Index

File No. N-23

R.D.: N.F.J.D.

Co. Survey No:

T.4S., R.32E.

N.F.: UMATILLA

County: Umatilla

Meridian: Willamette

CORNER DIAGRAM | DESCRIBE CORNER MONUMENT FOUND

T4S R32E | Found 16"x12"x8" basalt stone clearly marked 1/4 on
1/4 S13 | north face. Stone was set 8" deep.
S24 |
1994 |
PLS 2405 |

DESCRIBE BEARING TREES OR OTHER OFFICIAL ACCESSORIES FOUND

Found no remains of the original bearing trees

PHOTO ID DATA

Photo No.
Filed At
Object ID

PLANE CO-ORD


State Zone

X

Y | DESCRIBE CORNER LOCATION:

Estab. By | Corner falls on east slope of D.Fir and P.Pine.

Signature:

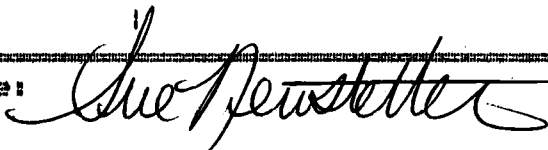

Title: Land Surveyor

Date: 10/18/94

CORNER RECORD (PERPETUATION)

MONUMENT: DESCRIBE NEW MONUMENT SET; OR WORK DONE TO PRESERVE EXISTING MON.
Moving the original corner stone aside, I set in it's place a 2-1/2"x30"
aluminum pipe with 3-1/2" aluminum cap, stamped as shown on the DIAGRAM,
26" in the ground and placed original stone north alongside. From which:

ACCESSORIES: DESCRIBE NEW BT'S, W.O.'S ETC. ESTABL./WORK DONE TO PRESERVE
Ponderosa Pine, 11" dia., bears N61°45'W, 32.3 ft., scribed: 1/4 S13 BT
Ponderosa Pine, 14" dia., bears N32°30'E, 35.8 ft., scribed: 1/4 S13 BT
Ponderosa Pine, 14" dia., bears S58°45'E, 30.8 ft., scribed: 1/4 S24 BT
Ponderosa Pine, 14" dia., bears S43°30'W, 9.9 ft., scribed: 1/4 S24 BT
Measurements to BT's taken with a magnetic compass, declination 20° East,
and a nylon clad steel tape. Set steel fence post with Land Survey
Monument (54-9) sign 5' south of the monument. Nailed a brass washer
stamped PLS 2405 on blaze above BT scribe as taken this survey. Nailed
Bearing Tree (54-3) signs above blaze and Land Survey Monument (54-9) signs
on back of each tree as required. Painted a 6" red band above Bearing
Trees signs.

Work Done by: Susan E. Newsletter Or. Land Surveyor No. 2405 Date: 10/18/94
Certified Cor. Record Prepared? Yes No Filed At: Umatilla Co. Survey.

REMARKS

Index File No. N-23

T.4S., R.32E., W.M.

Index
File No. N-23

CORNER RECORD (SEARCH)

(Ref. FSM 7151.4)

Tract or Survey No. _____ Cor. No. _____


T 4S R. 32E

R.D. Ukiah County Umatilla

Merid. Will.

N.F. Umatilla State Oregon

CORNER DIAGRAM

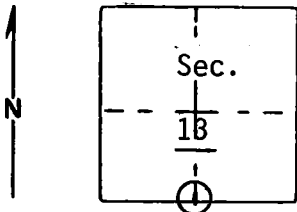

DESCRIBE CORNER MONUMENT FOUND

None

DESCRIBE BEARING TREES OR OTHER OFFICIAL ACCESSORIES FOUND

The area has been logged. No evidence of corner or accessories could be found. There is a primitive road nearby. See Owen Butte 7.5 minute quad map for access.

PHOTO IDENTIFICATION DATA

Photo No. _____

Filed At. _____

Object Ident. _____

Ident. By _____

Signature

PLANE COORDINATE POSITION DATA

State _____ Zone _____

X _____

Y _____

Estab. By _____

Agency

Signature

J. Hollaman

Title _____

Division _____

Headquarters _____

Date

4-21-77

7100-52-(3/68)

CORNER RECORD (PERPETUATION)

 MONUMENT: DESCRIBE NEW MONUMENT SET, OR WORK DONE TO PRESERVE EXISTING MONUMENT

9

 ACCESSORIES : DESCRIBE NEW BT'S WITNESS OBJECTS ETC. ESTABLISHED, OR WORK DONE TO PRESERVE EXISTING EVIDENCE

10

 Work Done By _____ Title _____ Date _____ State Registration No. _____
 or Agency _____

 Certified Cor. Record Prepared ? Yes No Filed At: _____ Date _____

REMARKS

12

 Index File No. T. R. M. Tract or Surv. No. Cor.

13