

Index
File No. N-9

CORNER RECORD (SEARCH)

(Ref. FSM 7151.4)


Tract or
Survey No. Cor.
No.

T 4 S R. 32 E

R.D. Ukiah County Umatilla

Merid. Willamette

N.F. Umatilla State Oregon

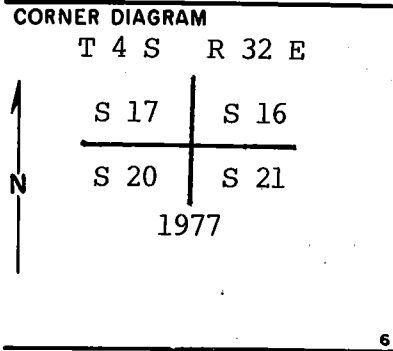

DESCRIBE CORNER MONUMENT FOUND

Found 2½" iron pipe with ¾" brass cap (as shown in corner diagram) in mound of stone.

DESCRIBE BEARING TREES OR OTHER OFFICIAL ACCESSORIES FOUND

- A 12" ponderosa pine, brs S52°W, 203.5' dist. with scribing visible.
- A 12" ponderosa pine, brs N32°W, 188.3' dist with scribing visible.
- A ponderosa pine sawn stump about 8' high 32" diam. brs N53¼°E, 140.1' with scribing visible.
- A 21" ponderosa pine, brs S50¼°E, 117.3' with scribing visible.

PHOTO IDENTIFICATION DATA

Photo No.

Filed At.

Object Ident.

Ident. By

Signature

DESCRIBE CORNER LOCATION RELATIVE TO NEAR-BY FEATURES, ALSO HOW TO REACH CORNER

Corner falls on Southerly slope just West of road, posted line N, S, E & W.

PLANE COORDINATE POSITION DATA

State Zone

X

Y

Estab. By

Agency

Signature
Wells R. Wells

Title
Land Surveyor

Division

Headquarters
Pendleton, Ore.

Date
6-02-92

FS-7100-52 (3/68)

CORNER RECORD (PERPETUATION)

MONUMENT: DESCRIBE NEW MONUMENT SET, OR WORK DONE TO PRESERVE EXISTING MONUMENT

Set steel fence post next to corner with sign 54-9 & 54-2 attached.
Compass declination 18° East.

9

ACCESSORIES: DESCRIBE NEW BT'S WITNESS OBJECTS ETC. ESTABLISHED, OR WORK DONE TO PRESERVE EXISTING EVIDENCE

New bearing tree established:
A 13" ponderosa pine brs N66 3/4°E, 162.0' dist. scribed T4SR32ES16 BT.
New BT's has a brass washer stamped PLS 1106 nailed to face of blaze.
Attached sign 54-3 & 54-9, painted face of blaze & a 6" red band
around each BT.

10

Work Done By W.R. Wells Title Land Surveyor Date 6-02-92 State Registration No. ORLS 1106
or Agency

Certified Cor. Record Prepared? Yes Filed At: Umatilla County Surveyor Date 7-92

11

REMARKS

12

Index File No. N-9 T. 4 S R. 32 E M. WM. Tract or Surv. No. Cor. 13