

Index  
File No. 0-13  
T 4 S R. 32 E  
Merid. Willamette


**CORNER RECORD (SEARCH)**

(Ref. FSM 7151.4)

Tract or Survey No. \_\_\_\_\_  
Cor. No. \_\_\_\_\_

R.D. Ukiah County Umatilla  
N.F. Umatilla State Oregon

**CORNER DIAGRAM**

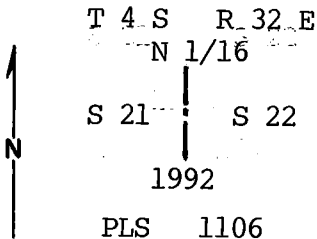

**DESCRIBE CORNER MONUMENT FOUND**

None. Corner established as part of this survey.

**DESCRIBE BEARING TREES OR OTHER OFFICIAL ACCESSORIES FOUND**

Found a rock mound bearing  $S 08^{\circ} W, 7\frac{1}{2}'$  from corner point with Kinzua location tag referencing it.

**PHOTO IDENTIFICATION DATA**

Photo No. \_\_\_\_\_  
Filed At. \_\_\_\_\_  
Object Ident. \_\_\_\_\_  
Ident. By \_\_\_\_\_  
*Signature*

**DESCRIBE CORNER LOCATION RELATIVE TO NEAR-BY FEATURES, ALSO HOW TO REACH CORNER**

Corner is located on East edge of ridgetop East of Owens Creek. Walk to corner from  $\frac{1}{4}$  corner to the North.

**PLANE COORDINATE POSITION DATA**

State \_\_\_\_\_ Zone \_\_\_\_\_  
X \_\_\_\_\_  
Y \_\_\_\_\_  
Estab. By \_\_\_\_\_  
*Agency*

*Signature*  
Willis R. Wells

*Title* Surveyor *Division*

*Headquarters*  
Pendleton, Ore.

*Date*  
6-05-92

FS-7100-52 (3/68)

CORNER RECORD (PERPETUATION)

MONUMENT: DESCRIBE NEW MONUMENT SET OR WORK DONE TO PRESERVE EXISTING MONUMENT

At position established by survey...

Set a 2 1/2"x30" aluminum pipe with 2 1/2" aluminum cap 22" in ground surrounded with mound of earth and stone. Set steel fence post South of corner and attached signs 54-2 & 54-9. Cap marked as shown in corner diagram. Compass declination 18° East.

9

ACCESSORIES : DESCRIBE NEW BT'S WITNESS OBJECTS ETC. ESTABLISHED, OR WORK DONE TO PRESERVE EXISTING EVIDENCE

New bearing trees established:

A 8" ponderosa pine brs N21 E, 69.8' scribed N1/16S22 BT.

A 17" ponderosa pine brs N17 1/2 W, 108.9' scribed N1/16S21 BT.

New BT's have a brass washer stamped PLS 1106 nailed to face of blaze.

Attached sign 54-3 & 54-9, painted face of blaze & a 6" red band around each BT.

10

Work Done By. W.R. Wells Title Land Surveyor Date 6-05-92 State Registration No. ORLS 1106 or Agency

Certified Cor. Record Prepared ? Yes ~~XXX~~ Filed At: Umatilla County Surveyor Date 7-92

11

REMARKS

Index File No. Q-13 T. 4 S. R. 32 E. M. W.M. Tract or Surv. No. Cor.

12

13