

Index  
File No. P-13

**CORNER RECORD (SEARCH)**

(Ref. FSM 7151.4)

Tract or  
Survey No. \_\_\_\_\_ Cor.  
No. \_\_\_\_\_


T 4 S R. 32 E

R.D. Ukiah County Umatilla

Merid. Willamette

N.F. Umatilla State Oregon

**CORNER DIAGRAM**

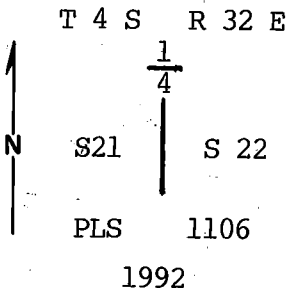

**DESCRIBE CORNER MONUMENT FOUND**

Found a basalt stone 14 x 10 x 10" firmly set and marked 1/4 on West face in mound of stone.

**DESCRIBE BEARING TREES OR OTHER OFFICIAL ACCESSORIES FOUND**

A 21" douglas fir snag bears S81°W, 27.6' with scribing visible.

**PHOTO IDENTIFICATION DATA**

Photo No. \_\_\_\_\_  
Filed At. \_\_\_\_\_  
Object Ident. \_\_\_\_\_  
Ident. By \_\_\_\_\_  
*Signature*

**DESCRIBE CORNER LOCATION RELATIVE TO NEAR-BY FEATURES, ALSO HOW TO REACH CORNER**

Corner falls on Southeasterly slope, West of road along creek to East.

**PLANE COORDINATE POSITION DATA**

State \_\_\_\_\_ Zone \_\_\_\_\_  
X \_\_\_\_\_  
Y \_\_\_\_\_  
Estab. By \_\_\_\_\_  
*Agency*

*Signature*  
Willie R. Wells

Title  
Land Surveyor

Division

Headquarters  
Pendleton, Ore.

Date  
6-09 -92

FS-7100-52 (3/68)

**CORNER RECORD (PERPETUATION)**

**MONUMENT: DESCRIBE NEW MONUMENT SET OR WORK DONE TO PRESERVE EXISTING MONUMENT**

At position of original round stone...

Set a 2½" X 30" aluminum pipe with 2½" aluminum cap 18" in ground surrounded with mound of earth and stone. Set steel fence post next to corner and attached signs 54-2 & 54-9. Cap marked as shown in corner diagram. Set original stone alongside mound. Compass declination 18° East.

9

**ACCESSORIES : DESCRIBE NEW BT'S WITNESS OBJECTS ETC. ESTABLISHED, OR WORK DONE TO PRESERVE EXISTING EVIDENCE**

New BT's have a brass washer stamped PLS 1106 nailed to face of blaze.

Attached sign 54-3 & 54-9, painted face of blaze & a 6" red band around each BT.

New bearing trees established:

A 14" western larch brs S36 3/4° E, 37.8' dist mkd 1/4S22 BT.

A 15" western larch brs S32 1/2° E, 42.2' dist mkd 1/4S22 BT.

A 15" ponderosa pine brs N50 1/2° W, 32.4' dist mkd 1/4S21 BT.

A 18" western larch brs S39 3/4° W, 127.4' dist mkd 1/4S21 BT.

10

Work Done By W.R. Wells Title Land Surveyor Date 6-09-92 State Registration No. ORLS 1106  
or Agency

Certified Cor. Record Prepared ? Yes  Filed At Umatilla County Surveyor Date 7-92

11

**REMARKS**


Index File No. P-13 T. 4 S. R. 32 E. M. Tract or Surv. No. WW. Cor. 13

Index  
 File No. P-13  
 T 4 S R. 32 E  
 Merid. Willamette

**CORNER RECORD (SEARCH)**  
 (Ref. FSM 7151.4)  
 R.D. Ukiah County Umatilla  
 N.F. Umatilla State Oregon

Tract or  
 Survey No. 122-75 Cor. No. P-13

**CORNER DIAGRAM**

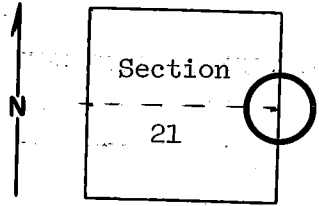

**DESCRIBE CORNER MONUMENT FOUND**

Material: None.

**DESCRIBE BEARING TREES OR OTHER OFFICIAL ACCESSORIES FOUND**

Forest Service boundary timber sale posters on west face of trees north-south line (logged area).

**PHOTO IDENTIFICATION DATA**

Photo No. \_\_\_\_\_  
 Filed At. \_\_\_\_\_  
 Object Ident. \_\_\_\_\_  
 Ident. By \_\_\_\_\_  
 Signature \_\_\_\_\_

**DESCRIBE CORNER LOCATION RELATIVE TO NEAR-BY FEATURES, ALSO HOW TO REACH CORNER**

**PLANE COORDINATE POSITION DATA**

State \_\_\_\_\_ Zone \_\_\_\_\_  
 X \_\_\_\_\_  
 Y \_\_\_\_\_  
 Estab. By \_\_\_\_\_  
 Agency \_\_\_\_\_

Signature B. Moore Title Engineering Technician Division COB& (Headquarters) S. O. \_\_\_\_\_

Date April 1975 7100-52-(3/68)

**CORNER RECORD (PERPETUATION)**

**MONUMENT: DESCRIBE NEW MONUMENT SET, OR WORK DONE TO PRESERVE EXISTING MONUMENT**

9

**ACCESSORIES : DESCRIBE NEW BT'S WITNESS OBJECTS ETC. ESTABLISHED, OR WORK DONE TO PRESERVE EXISTING EVIDENCE**

10

Work Done By \_\_\_\_\_ Title \_\_\_\_\_ Date \_\_\_\_\_ State Registration No. or Agency \_\_\_\_\_

Certified Cor. Record Prepared ? Yes No Filed At: \_\_\_\_\_ Date \_\_\_\_\_

11

**REMARKS**

12

Index File No. T. R. M. Tract or Surv. No. Cor.

13