

Index  
File No. Q-16

**CORNER RECORD (SEARCH)**

(Ref. FSM 7151.4)


Tract or Survey No. \_\_\_\_\_ Cor. No. \_\_\_\_\_

T 4 S R. 32 E

R.D. Ukiah County Umatilla

Merid. Willamette

N.F. Umatilla State Oregon

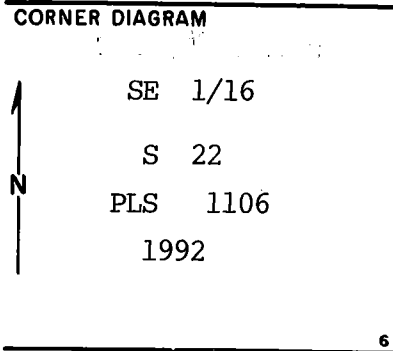

**DESCRIBE CORNER MONUMENT FOUND**

None. Corner established as part of this survey.

**DESCRIBE BEARING TREES OR OTHER OFFICIAL ACCESSORIES FOUND**

None.

**PHOTO IDENTIFICATION DATA**

Photo No. \_\_\_\_\_

Filed At. \_\_\_\_\_

Object Ident. \_\_\_\_\_

Ident. By \_\_\_\_\_

*Signature* \_\_\_\_\_

**DESCRIBE CORNER LOCATION RELATIVE TO NEAR-BY FEATURES, ALSO HOW TO REACH CORNER**

Corner falls on Westerly slope, posted line S & W.

**PLANE COORDINATE POSITION DATA**

State \_\_\_\_\_ Zone \_\_\_\_\_

X \_\_\_\_\_

Y \_\_\_\_\_

Estab. By \_\_\_\_\_

*Agency* \_\_\_\_\_

Signature  
*Will R. Wells*

Title  
Land Surveyor

Division  
Headquarters  
Pendleton, Ore.

Date  
6-11-92

FS-7100-52 (3/68)

CORNER RECORD (PERPETUATION)

MONUMENT: DESCRIBE NEW MONUMENT SET, OR WORK DONE TO PRESERVE EXISTING MONUMENT

At position established by survey...

Set a 2 1/2" X 30" aluminum pipe with 2 1/2" aluminum cap 21" in ground surrounded with mound of earth and stone set steel fence post next to corner and attached signs 54-2 & 54-9. Cap marked as shown in corner diagram.

Compass declination 18° East.

9

ACCESSORIES : DESCRIBE NEW BT'S WITNESS OBJECTS ETC. ESTABLISHED, OR WORK DONE TO PRESERVE EXISTING EVIDENCE

New bearing trees established:

A 16" ponderosa pine brs S59 1/2° E, 103.0' scribed SE1/16S22 BT.

A 17" ponderosa pine brs S11 1/4° W, 44.5' scribed SE1/16S22 BT.

New BT's have a brass washer stamped PLS 1106 nailed to face of blaze.

Attached sign 54-3 & 54-9, painted face of blaze & a 6" red band around each BT.

10

Work Done By W.R. Wells Title Land Surveyor Date 6-11-92 State Registration No. ORLS 1106  
or Agency

Certified Cor. Record Prepared ? Yes XXX Filed At Umatilla County Surveyor Date 7-92

11

REMARKS

Index File No. Q-11 T. 4 S. R. 32 E. WM. Tract or Surv. No. Cor. 13