

Index
 File No. Q-9
 T 4 S R. 32 E
 Merid. Willamette


CORNER RECORD (SEARCH)

(Ref. FSM 7151.4)

Tract or
 Survey No. _____ Cor.
 No. _____

R.D. Ukiah County Umatilla
 N.F. Umatilla State Oregon

CORNER DIAGRAM

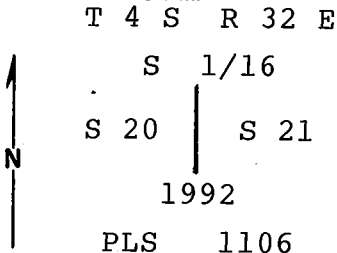

DESCRIBE CORNER MONUMENT FOUND

Found a small stone mound S-72°E, 4' from corner point.

DESCRIBE BEARING TREES OR OTHER OFFICIAL ACCESSORIES FOUND

None established during original survey.

PHOTO IDENTIFICATION DATA

Photo No. _____
 Filed At. _____
 Object Ident. _____
 Ident. By _____
 Signature _____

DESCRIBE CORNER LOCATION RELATIVE TO NEAR-BY FEATURES, ALSO HOW TO REACH CORNER

Corner located on a large open ridgetop. Corner can be driven to.

PLANE COORDINATE POSITION DATA

State _____ Zone _____
 X _____
 Y _____
 Estab. By _____
 Agency _____

Signature
William R. Niles

Title Land Surveyor Division _____ Headquarters Pendleton, Ore.

Date 6-6-92

6

7

8

2

3

4

5

CORNER RECORD (PERPETUATION)

MONUMENT: DESCRIBE NEW MONUMENT SET, OR WORK DONE TO PRESERVE EXISTING MONUMENT

At position established by survey...

Set a 2 1/2"x30" aluminum pipe with 1/2" aluminum cap 15" in ground to rock, surrounded with mound of earth and stone & 6' steel fence post South of corner and attached signs 54-2 & 54-9. Cap marked as shown in corner diagram.

Compass declination 18° East.

9

ACCESSORIES: DESCRIBE NEW BT'S, WITNESS OBJECTS ETC. ESTABLISHED, OR WORK DONE TO PRESERVE EXISTING EVIDENCE

New bearing trees established:

A 21" ponderosa pine brs N07 1/2° W, 186.9' scribed S1/16S20 BT.

A 17" ponderosa pine brs S73 1/2° E, 249.6' scribed S1/16S21 BT.

New BT's have a brass washer stamped PLS 1106 nailed to face of blaze.

Attached sign 54-3 & 54-9, painted face of blaze & a 6" red band around each BT.

10

Work Done By W.R. Wells Title Land Surveyor Date 6-6-92 State Registration No. ORLS 1106 or Agency

Certified Cor. Record Prepared? Yes Filed At Umatilla County Surveyor Date 7-92

11

REMARKS

Index File No. Q-9 T. 4 S. R. 32 E. WM M. Tract or Surv. No. Cor. 13