

USDA-FOREST SERVICE

Index
File No. X-21

CORNER RECORD (SEARCH)

(Ref. FSM 7151.4)

Tract or Survey No. _____
Cor. No. 1/4


T 45 R. 33E

R.D. Ukiah County Umatilla

Merid. Willamette

N.F. Umatilla State Oregon

CORNER DIAGRAM

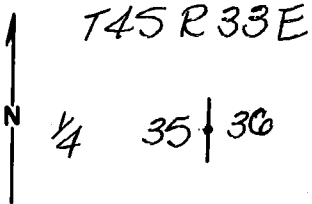

DESCRIBE CORNER MONUMENT FOUND

BLM Brass Cap stamped 1977, 3" in dia.

DESCRIBE BEARING TREES OR OTHER OFFICIAL ACCESSORIES FOUND

A 9" Fir bears N 72° E, 27 lks
A 12" Pine bears N 34° W, 59 lks

PHOTO IDENTIFICATION DATA

Photo No. _____
Filed At. _____
Object Ident. _____
Ident. By _____
Signature

PLANE COORDINATE POSITION DATA

State _____ Zone _____
X _____
Y _____
Estob. By _____
Agency

DESCRIBE CORNER LOCATION RELATIVE TO NEAR-BY FEATURES, ALSO HOW TO REACH CORNER

From jct. of Ukiah-Hilgard Highway and Forest Road
54 drive east 1.8 mi, park, walk uphill 100 feet to
corner $\frac{35}{21}$ then 1/2 mile to corner.

Signature
David H Klein

Title PLS 935 Division

Headquarters

Date 7-1983 7100-52 (3-68)

CORNER RECORD (PERPETUATION)

MONUMENT: DESCRIBE NEW MONUMENT SET, OR WORK DONE TO PRESERVE EXISTING MONUMENT

None

ACCESSORIES: DESCRIBE NEW BT'S WITNESS OBJECTS ETC. ESTABLISHED, OR WORK DONE TO PRESERVE EXISTING EVIDENCE

Painted Blazes and a band with red paint
Nailed Attention signs

Work Done By D Keumbein Title Surveyor Date 7-1983 State Registration No. PLS 933
or Agency

Certified Cor. Record Prepared? Yes No Filed At: _____ Date _____

REMARKS

Index File No. X-21 T. 45 R. 33 E M. Willamette Tract or Surv. No. _____ Cor. 14