

USDA-FOREST SERVICE

Index

File No. 2-14

CORNER RECORD (SEARCH)

(Ref. FSM 7151.4)

Tract or Survey No. \_\_\_\_\_

Cor. No. W 1/2

T 43 R. 33E


R.D. Ukiah County Umatilla

Merid. Willamette

N.F. Umatilla State Oregon

CORNER DIAGRAM

T43R33E

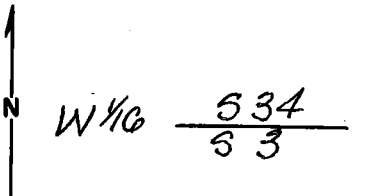

DESCRIBE CORNER MONUMENT FOUND

None

DESCRIBE BEARING TREES OR OTHER OFFICIAL ACCESSORIES FOUND

None

PHOTO IDENTIFICATION DATA

Photo No. \_\_\_\_\_  
 Filed At. \_\_\_\_\_  
 Object Ident. \_\_\_\_\_  
 Ident. By \_\_\_\_\_  
*Signature*

PLANE COORDINATE POSITION DATA

State \_\_\_\_\_ Zone \_\_\_\_\_  
 X \_\_\_\_\_  
 Y \_\_\_\_\_  
 Estab. By \_\_\_\_\_  
*Agency*

DESCRIBE CORNER LOCATION RELATIVE TO NEAR-BY FEATURES, ALSO HOW TO REACH CORNER

From jet of Ukiah - Hilgard Highway and Forest Road 54 go South 0.2 mi., park and walk East 300 feet to corner.

Signature David H Klein

Title P.L.S. 933 Division \_\_\_\_\_


Headquarters \_\_\_\_\_

Date 7-1983 7100-52 (3-68)

**CORNER RECORD (PERPETUATION)**

**MONUMENT: DESCRIBE NEW MONUMENT SET, OR WORK DONE TO PRESERVE EXISTING MONUMENT**

Set a 2 1/2" dia. Brass Cap on a 2 1/2" dia. x 30" galvanized pipe set  
22" in ground marked:

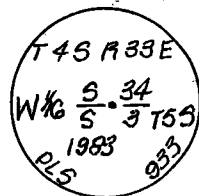

**ACCESSORIES: DESCRIBE NEW BT'S WITNESS OBJECTS ETC. ESTABLISHED, OR WORK DONE TO PRESERVE EXISTING EVIDENCE**

A 6" dia. pine bears S44°W, 82.0 feet scribed T5S R33E 1/6 S3 BT  
A 8" dia. pine bears N88°30'E, 135.6 feet scribed T4S R33E 1/6 S34 BT  
Blazes are painted red, Trees have a red band painted around them.  
Trees have sign numbers 54-3, 54-9, + Brass Washers stamped PLS.  
933 nailed to them.

Work Done By D. Krumbain Title Surveyor Date 7-1983 State Registration No. PLS 933  
or Agency

Certified Cor. Record Prepared?  Yes No Filed At: Umatilla County Date 7-1983

REMARKS

Index File No. 2-14 T. 4S R. 33E M. Willamette Tract or Surv. No.          Cor. W 1/6