


Index
File No. P-25
T 4S R. 33 1/2 E
Merid. WILLAMETTE

CORNER RECORD (SEARCH)

(Ref. FSM 7151.4)

R.D. LA GRANDE County UNION Tract or Survey No. _____
N.F. WALLOWA-WHITMAN State OREGON Cor. No. E. 1/4 COR. SEC. 24

CORNER DIAGRAM

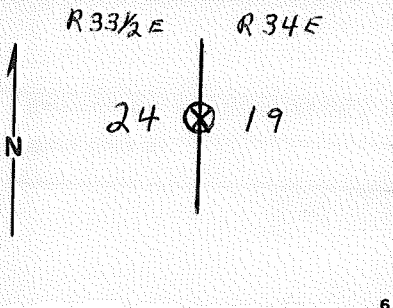

DESCRIBE CORNER MONUMENT FOUND

Rock, 8x12x9, is ground level and in poor condition.
4 rocks assumed to be 1/4 cor.

DESCRIBE BEARING TREES OR OTHER OFFICIAL ACCESSORIES FOUND

B.T. 20" ponderosa pine, approx. 90' S. 60° W. from cor. Location poster on this one.
Possible B.T. 34" dead ponderosa pine snag, 143' (approx) E. of cor.
I painted the cor. & B.T.'s red. Shields are needed for the BT's.

DESCRIBE CORNER LOCATION RELATIVE TO NEAR-BY FEATURES, ALSO HOW TO REACH CORNER

The corner is in an opening, 25' W. of corner is a very small draw. The cor. is approx. 843' N. of Salsbury Road.

PHOTO IDENTIFICATION DATA

Photo No. UBM 4-3
Filed At. _____
Object Ident. _____
Ident. By _____
Signature

PLANE COORDINATE POSITION DATA

State _____ Zone _____
X _____
Y _____
Estab. By _____
Agency

Signature
SAK & JMW

Title _____ Division _____ Headquarters _____

Date
11/10/65

7100-52-(3/68)

CORNER RECORD (PERPETUATION)

MONUMENT: DESCRIBE NEW MONUMENT SET, OR WORK DONE TO PRESERVE EXISTING MONUMENT

9

ACCESSORIES : DESCRIBE NEW BT'S WITNESS OBJECTS ETC. ESTABLISHED, OR WORK DONE TO PRESERVE EXISTING EVIDENCE

10

Work Done By _____ Title _____ Date _____ State Registration No. or Agency _____

Certified Cor. Record Prepared ? Yes No Filed At. _____ Date _____

11

REMARKS

12

Index File No. T. R. M. Tract or Surv. No. Cor. _____

13