


CERTIFIED RECORD OF LAND CORNER MONUMENTATION / RESTORATION

T.5N., R.27E., INDEX V-21

History of original corner establishment:

This corner was originally established by Timothy Davenport under G.L.O. contract No. 101, dated August 5, 1861. Survey General notes state:

Set post corner to Secs 25, 26, 35 & 36, made mound and drove charred stake as per inst.

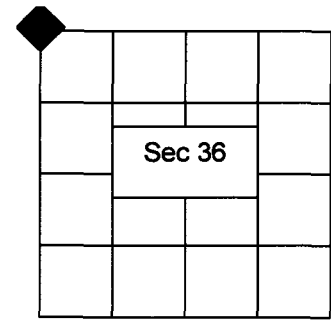

Description of corner evidence found:

No evidence of this corner is found. Set monument at double proportionate measure.

Description of monument and accessories I establish to perpetuate the original location of this corner:

At proportionate position determined by survey, Set a 2-1/2" x 30" aluminum pipe monument with 3" dia. cap stamped as shown in the DIAGRAM, 8" blow the gravel road surface, from which:

- A 5/8" rebar pin bears N42°38'26"W, 36.95 ft.
- A 5/8" rebar pin with 1 groove filed on the top, bears N35°04'54"E, 30.51 ft.
- The north face of an 8" dia. irrigation stand pipe bears S34°47'25"E, 53.80 ft.
- Twisted spike in a utility pole bears S88°24'23"W, 73.59 ft.

Placed an orange plastic cap marked "FS&E Survey Marker" on all rebar pins.

Measurements to accessories taken with: Topcon Hyper II GPS (RTK)

I hereby certify that the above corner point was perpetuated as shown hereon on July 29, 2015

Witness: D. Mitchell Ferguson, LSIT
David Herburger


DIAGRAM
T5N R27E
S26 | S27

S35 | S36
2015
PLS 49865

Office of County Surveyor _____ County of Umatilla
State of Oregon _____. I hereby certify that the within instrument was filed in this office
for record on the 27th day of January, 2016

_____ by David Herburger
County Surveyor Deputy

Refer to Map of Survey # 16-018-C

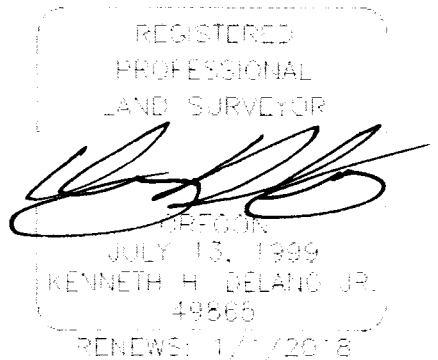

16-018-C