

CERTIFIED RECORD OF LAND CORNER MONUMENTATION / RESTORATION


T.5N., R.27E., INDEX Z-21

History of original corner establishment:

This corner was re-established by Otis Gould under G.L.O. special instructions dated September 9, 1940 and approved on January 9, 1941.

Survey General notes state:

Proportionate measurement. Set an iron post 3 ft. long, 2 ins. diam., 27 ins. in the ground, with broken glass deposited at the base, for standard cor. of secs. 35 & 36, with brass cap.

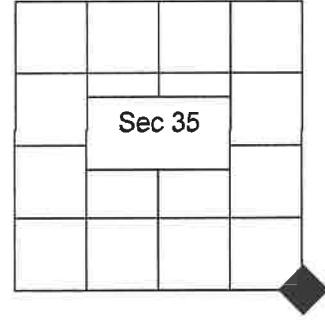

Description of corner evidence found:

No evidence of this corner is found. Appears to be lost to ground clearing/excavation activities associated the weapons depot.

Description of monument and accessories I establish to perpetuate the original location of this corner:

At the proportionate position determined on Umatilla County Map of Survey #16-018-C, done by me and filed on January 27, 2016 in the Umatilla County Survey records, I set a 2-3/8" x 30" aluminum pipe monument w/3" dia. cap stamped as shown in the DIAGRAM, 26" in the ground, from which:

- A 5/8" dia. x 30" rebar pin bears N00°49'13"W, 50.00 ft.
- A 5/8" dia. x 30" rebar pin bears N89°17'38"E, 50.00 ft.
- A 5/8" dia. x 30" rebar pin bears South, 36.00 ft. (1 ft. north of the old E-W Umatilla Weapons Depot security fence)
- A 5/8" dia. x 30" rebar pin bears S89°17'38"W, 50.00 ft.

All rebar pins are capped with a yellow plastic cap marked "Survey Marker PLS 49865". Set 5' t-post with a Land Survey Monument sign 2' North of monument.

DIAGRAM

T5N R27E
SC
S35 | S36

S 1
T4N R27E
2025
PLS 49865

Measurements to accessories taken with:

Trimble R6 Base & R8 rover. Basis of Bearings are said Survey #16-018-C

Observed raw rtk: Lat N 45°51'53.45644"
Long W 119°23'26.28983"

I hereby certify that the above corner point was perpetuated as shown hereon on July 30, 2025

Witness:

Office of County Surveyor County of UMATILLA
State of Oregon. I hereby certify that the within instrument was filed in this office for record on the _____ day of _____, 2025

_____ by _____
County Surveyor Deputy

REGISTERED
PROFESSIONAL
LAND SURVEYOR

[Signature]
OREGON
JULY 13, 1999
KENNETH H. DELANO JR.
49865
RENEWS: 1/1/2026