

OREGON CORNER RESTORATION FORM

SECTION 19 TOWNSHIP 5N RANGE 28E N-5

COUNTY: UMATILLA DATE 1/90

CORNER DESIGNATION

NE Corner

- CONDITION REPORT ONLY
- NOT FOUND
- RENEWED
- UNRECORDED
- SURVEYED IN
- REFERENCED OUT


PREVIOUS RENEWALS/SURVEYS, ETC.

Original survey by Davenport in 1861 under Contract #101. BLM Dependent Resurvey by Frank A. Tuers completed Sept. 12, 1975


MONUMENTS & ACCESSORIES FOUND: Condition and Source

Found a 3 1/4" Dept. of Interior (BLM) Brass Cap stamped, as shown below. This monument replaced a conc. cylinder found at this location by Tuers. This cap is now in concrete at the surface of an asphalt street.

MONUMENT DETAIL

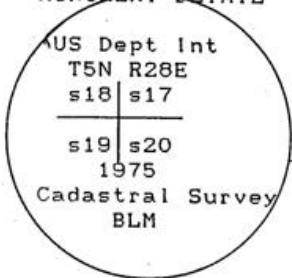

SKETCH

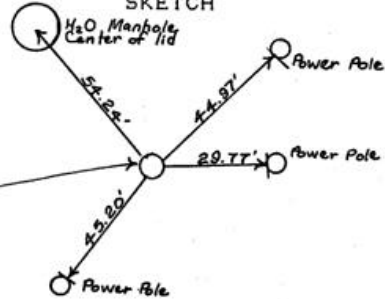

MONUMENT SET (PROCEDURES AND DESCRIPTION)

NEW ACCESSORIES

From which
 Center of H2O manhole, N 41° 18' 30" W: 54.24 feet,
 Power pole w/ Alum. Tag #951, Bearing Object & Witness signs attached. N 46° 07' 20" E 44.97 feet, Dist. To Alum. Tag.
 Power pole w/ Alum. Tag #951, Bearing Object sign N 85° 34' 10" E 29.77 feet, Dist. To Alum. Tag
 Power pole w/ Alum. Tag #951, Bearing Object & Witness Corner signs S 36° 50' 40" W. 45.20 feet. Dist. To Alum. Tag

LOCATION & COMMENTS

At the intersection of Grant and Van Buren, Umatilla, Oregon.

SURVEYOR'S SEAL

COMPASS DEC.
 FIRM EDWARDS SURVEYING
 P.O. BOX 763, HERMISTON,
 OREGON, 97838
 PARTY CHIEF D. EDWARDS
 NOTES
 WITNESS J. COPPOCK

REGISTERED
 PROFESSIONAL
 LAND SURVEYOR

G. Dennis Edwards

OREGON
 JULY 16, 1971
 G. DENNIS EDWARDS
 951

RECEIVED BY

Umatilla County Surveyor
 Date 1-91
 Rec'd By LA
 No. 91-01-B