

OREGON CORNER RESTORATION FORM

2-15

Section 34 Township 5N Range 28E

County Umatilla Date 5/18/95

CORNER DESIGNATION



S 1/4 Sec. 34
(Standard 1/4 Corner)

- Condition Report Only
- Not Found
- Renewed
- Unrecorded
- Surveyed In
- Referenced Out

Previous Renewals/Surveys, etc. H. J. G. Maxon & Jared Hurd set post in mound of earth with trench & pits in 1860; Driver set RR spike in 1976; Krumbein set Brass cap in 1980; Edwards found P-K with Monument(s) & Accessories Found: (Condition and Source) straddles in Found P-K nail with straddles - no evidence of brass cap. 1993

Monument Detail

Sketch

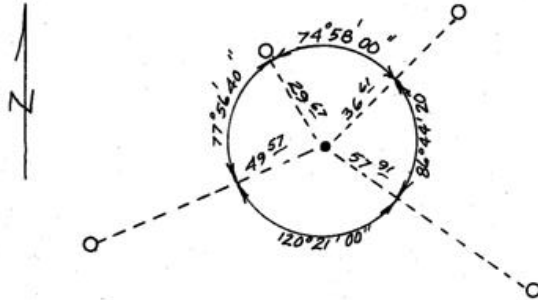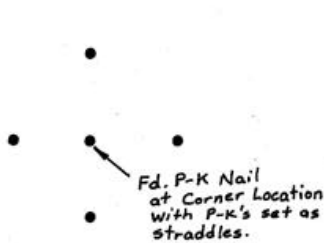

Monument Set (Procedures and Description)

New Accessories

Set 4 - 5/8" x 30" iron pins with yellow plastic caps marked "UMA CO R D LS 2627", one in each quadrant, with "Please do not disturb" and bearing object tags near each.

Location & Comments

Surveyor's Seal

In the intersection of West Punkin Center Road and Kik Road near Hermiston. Compass Declination _____
 Firm/Agency Umatilla County Rd. Dept.
 Address 3920 Westgate

RECEIVED BY

Pendleton, Oregon 97801 *Jay R. Roberts*

Umatilla County Surveyor

Party Chief Gary Roberts

Date 5-95

Notes Gary Roberts

Rec'd By KL

Witness Chris Amsberry

No. 95-81-P

REGISTERED PROFESSIONAL LAND SURVEYOR
OREGON
 JULY 20, 1993
GARY R. ROBERTS
 2627