

OREGON CORNER RESTORATION FORM

Section: 32 & 33
Township: 5 North
Range: 28 East of the Willamette Meridian
County: Umatilla
Date: 2/02/2024
Corner Indexing Information: Township 5N Range 28E Corner Code Z-9 (Willamette Meridian)
Additional Identifier: South standard corner common to Sections 32 & 33

Oregon Plane Coordinates: N: 803550.24 E: 8500644.38 Zone: North Order: Second
Datum: NAD83-2011(epoch 2010) Convergence: N00°49'52"W Scale Factor: 1.000044268448

Previous Renewals/Surveys, etc.:

- 1861: Set post, mound, pits, & charred stake (Maxson & Hurd, G.L.O. Contract No. 50)
1910: Corner found, not described (J. Kimbrell, C.S. 313)
1941: Found basalt stone 12x10x9 ins. set under surface of road, marked with a cross (X). Set iron post, 3 ft. long, 2 ins. diam., 48 ins. in the ground 1 ft. under surface of road with basalt stone deposited at the base. 25 lks. North of the corner, set iron post 3 ft. long 2 ins. diam. 27 ins. in the ground with broken glass deposited at the base for witness corner to the standard cor. with brass cap. (Gould, GLO Special Instructions of 9/9/1940)
1980: Found bent iron pipe over stone marked with an X; found W.C. by Gould 16.50' North. Replaced pipe with a 2-1/2" brass cap 6" below road surface (Krumbein, C.S. S-156-C)

Monument(s) & Accessories Found (Condition & Source):

Found 2-1/2" brass cap per C.S. S-156-C, 9" deep in centerline of Country Lane; found W.C. brass cap by Gould N00°10'03"E 16.42' ; found 3-3/4" brass cap marked "U.S. RECLAMATION SERVICE B.M. 461.09 FEET" N03°15'41"E 18.37'.

Monument Set (Procedures & Description):

N/A

Monument Detail:

T5N R28E
S.C.
S32 S33
1980
LS933

New Accessories: WE SET:

Set 5/8"x30" iron rebar with yellow plastic cap marked "PBS WA19619 OR02820" bearing S76°04'29"W 82.20 feet from the corner; set bearing tag on adjacent power pole;
Set 5/8"x30" iron rebar with yellow plastic cap marked "PBS WA19619 OR02820" 1' south of East-West fence, bearing N69°49'22"W 50.01 feet from the corner; set bearing tag on adjacent fence post;
Attached bearing tag to 3-3/4" U.S. Reclamation brass cap as noted above;
Set 5/8"x30" iron rebar with yellow plastic cap marked "PBS WA19619 OR02820" bearing S85°12'12"E 207.12 feet from the corner; set bearing tag on adjacent power pole.

Location & Comments:

Corner lies +-920' easterly along Country Lane from the intersection of Country Lane and County Road 1243.


Compass Declination:

All accessories tied with State Plane grid bearings.

Firm/Agency: PBS Engineering & Environmental, Inc
5 N. Colville
Walla Walla WA 99362

Witness: Felipe Hernandez
Hayden Lomeli

Surveyor's Seal

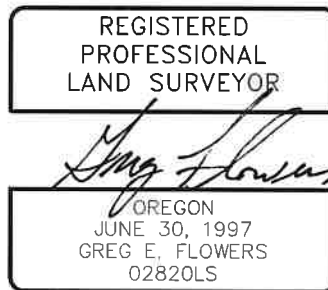

RENEWS 12/31/2025
2/07/2024