

OREGON CORNER RESTORATION FORM

SECTION 13, 14 TOWNSHIP 5 NORTH RANGE 29 EAST

L-21

COUNTY : UMATILLA DATE DEC/22

CORNER DESIGNATION

1/4 CORNER

CONDITION REPORT ONLY
 NOT FOUND
 RENEWED
 UNCOVERED
 SURVEYED IN
 REFERENCED

PREVIOUS RENEWALS / SURVEYS, ETC.


SURVEYED IN 1861 BY DAVENPORT UNDER CONTRACT #101, HE SET POST AND MADE MOUND.
IN 1949 STRANIX FOUND 2" IRON PIPE AND SET A CONCRETE MONUMENT.

MONUMENTS AND ACCESSORIES FOUND: CONDITION AND SOURCE

FOUND CONCRETE MONUMENT.

FOUND 5/8" IRON ROD WITH YELLOW PLASTIC CAP STAMPED LS 951 BEARS N 50°55'42" E, 4.84'.
FOUND 5/8" IRON ROD WITH YELLOW PLASTIC CAP STAMPED LS 951 BEARS N 03°14'39" W, 23.17'.
FOUND 5/8" IRON ROD WITH YELLOW PLASTIC CAP STAMPED LS 951 BEARS S 88°31'57" W, 29.46'.
FOUND 5/8" IRON ROD WITH YELLOW PLASTIC CAP STAMPED LS 951 BEARS S 02°51'38" W, 20.50'.

MONUMENT DETAIL

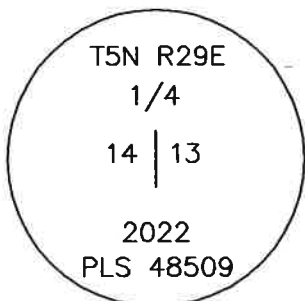

NAD 83/91
OREGON STATE PLANE
INTERNATIONAL FEET

822650.61
8548023.43

MONUMENT SET (PROCEDURES AND DESCRIPTION)

SET 2" ALUMINUM CAP IN CONCRETE STAMPED AS ABOVE FROM ACCESSORIES FOUND.

NEW ACCESSORIES FROM WHICH

LOCATION AND COMMENTS

CORNER FALLS AT A FENCE CORNER
AND NORTH +/- 500 FEET OF
HIGHWAY 730 AND +/- 600 FEET
WEST OF STATE TRUCK SCALES.

FIRM/AGENCY

PRIMM LAND SURVEYING, INC.
P.O. BOX 1322
HERMISTON, OREGON 97838

LAND SURVEYOR

BRIT L. PRIMM

WITNESS

KEITH P. PRIMM

SURVEYOR'S SEAL

REGISTERED
PROFESSIONAL
LAND SURVEYOR

OREGON
JULY 13, 1999
BRIT L. PRIMM
48509

EXPIRATION DATE: 12/31/24

23-012-C