

OREGON CORNER RESTORATION FORM

SECTION 13, 18 TOWNSHIP 5 NORTH RANGE 29 EAST, RANGE 30 EAST

L-25

COUNTY : UMATILLA DATE DEC/22

CORNER DESIGNATION

1/4 CORNER

- CONDITION REPORT ONLY
- NOT FOUND
- RENEWED
- UNCOVERED
- SURVEYED IN
- REFERENCED


PREVIOUS RENEWALS / SURVEYS, ETC.

SURVEYED IN 1861 BY PAYNE UNDER CONTRACT #100, HE SET POST WITH MOUND.
IN 1949 STRANIX SET A RAIL ROAD SPIKE IN ROCK.
IN 2005 LS 951 SET A 2 3/8" BRASS CAP.

MONUMENTS AND ACCESSORIES FOUND: CONDITION AND SOURCE

FOUND 2 3/8" BRASS CAP STAMPED AS BELOW.
FOUND 5/8" IRON ROD WITH YELLOW PLASTIC CAP STAMPED LS 951 BEARS N 84°40'04" E, 32.29'.
FOUND 5/8" IRON ROD WITH YELLOW PLASTIC CAP STAMPED LS 951 BEARS N 34°32'19" E, 22.66'.
FOUND 5/8" IRON ROD WITH YELLOW PLASTIC CAP STAMPED LS 951 BEARS N 44°12'14" W, 150.70'.

MONUMENT DETAIL

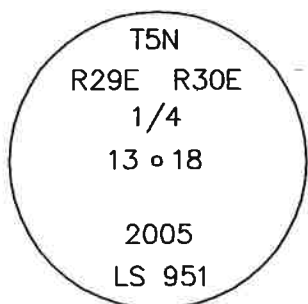

NAD 83/91
OREGON STATE PLANE
INTERNATIONAL FEET

822670.95
8553237.75

MONUMENT SET (PROCEDURES AND DESCRIPTION)

NEW ACCESSORIES FROM WHICH

SET 5/8" X 30" IRON ROD WITH YELLOW PLASTIC CAP STAMPED PLS LS 48509 BEARS N 61°06'03" W, 358.36'.

LOCATION AND COMMENTS

FROM INTERSECTION OF HIGHWAY
730 AND COLD SPRINGS HIGHWAY,
GO SOUTHEASTERLY ALONG COLD
SPRINGS HIGHWAY +/- 0.9 MILES.
CORNER FALLS ON SOUTHERLY SIDE
OF HIGHWAY +/- 30 FEET.

FIRM/AGENCY

PRIMM LAND SURVEYING, INC.
P.O. BOX 1322
HERMISTON, OREGON 97838

LAND SURVEYOR

BRIT L. PRIMM

WITNESS

KEITH P. PRIMM

SURVEYOR'S SEAL

REGISTERED
PROFESSIONAL
LAND SURVEYOR

OREGON
JULY 13, 1999
BRIT L. PRIMM
48509

EXPIRATION DATE: 12/31/24