

# OREGON CORNER RESTORATION FORM

SECTION 15, 16, 21, 22 TOWNSHIP 5 NORTH RANGE 29 EAST  
COUNTY : UMATILLA DATE DEC/22

N-13

CORNER DESIGNATION  
SECTION CORNER

CONDITION REPORT ONLY  
 NOT FOUND  
 RENEWED  
 UNCOVERED  
 SURVEYED IN  
 REFERENCED


PREVIOUS RENEWALS / SURVEYS, ETC.

SURVEYED IN 1861 BY DAVENPORT UNDER CONTRACT #101, HE SET POST AND MADE MOUND.  
IN 1971 HARRIS SET A 2 1/2" BRASS CAP. NOT FOUND.  
IN 2005 LS 951 SET A 2 3/8" BRASS CAP.

MONUMENTS AND ACCESSORIES FOUND: CONDITION AND SOURCE

FOUND 2 3/8" BRASS CAP STAMPED AS BELOW.  
FOUND 5/8" IRON ROD WITH YELLOW PLASTIC CAP STAMPED LS 951 BEARS N 20°49'20" W, 55.99'.  
FOUND 5/8" IRON ROD WITH YELLOW PLASTIC CAP STAMPED LS 951 BEARS N 27°46'41" W, 41.79'.  
FOUND 5/8" IRON ROD WITH YELLOW PLASTIC CAP STAMPED LS 951 BEARS S 58°50'56" W, 22.73'.  
FOUND 5/8" IRON ROD WITH YELLOW PLASTIC CAP STAMPED LS 951 BEARS S 04°55'54" W, 244.17'.

MONUMENT DETAIL

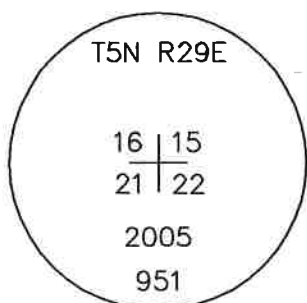

NAD 83/91  
OREGON STATE PLANE  
INTERNATIONAL FEET

819806.42  
8537508.40

MONUMENT SET ( PROCEDURES AND DESCRIPTION )

NEW ACCESSORIES FROM WHICH

LOCATION AND COMMENTS

FROM INTERSECTION OF SALMON  
POINT DRIVE AND HIGHWAY 730 GO  
NORTH ALONG SALMON POINT DRIVE  
+/- 0.45 MILES. CORNER FALLS  
+/- 30 FEET EAST OF ROAD.

FIRM/AGENCY

PRIMM LAND SURVEYING, INC.  
P.O. BOX 1322  
HERMISTON, OREGON 97838

LAND SURVEYOR

BRIT L. PRIMM

WITNESS

KEITH P. PRIMM

SURVEYOR'S SEAL

REGISTERED  
PROFESSIONAL  
LAND SURVEYOR

*Brit L. Primm*  
OREGON  
JULY 13, 1999  
BRIT L. PRIMM  
48509

EXPIRATION DATE: 12/31/24