

# OREGON CORNER RESTORATION FORM

SECTION 19, 24 TOWNSHIP 5 NORTH RANGE 29 EAST, RANGE 30 EAST  
 COUNTY : UMATILLA DATE DEC/22

P-25

CORNER DESIGNATION  
 1/4 CORNER

- CONDITION REPORT ONLY
- NOT FOUND
- RENEWED
- UNCOVERED
- SURVEYED IN
- REFERENCED


PREVIOUS RENEWALS / SURVEYS, ETC.

SURVEYED IN 1861 BY PAYNE UNDER CONTRACT #100, HE SET A STAKE AND MADE MOUND.  
 IN 1949 STRANIX FOUND OLD STAKE.  
 IN 2005 LS 951 SET A 2 3/8" BRASS CAP 25" BELOW THE SURFACE OF A CULTIVATED CROP.

MONUMENTS AND ACCESSORIES FOUND: CONDITION AND SOURCE

FOUND 2 3/8" BRASS CAP 25" BELOW SURFACE OF CULTIVATED CROP STAMPED AS BELOW.  
 FOUND 5/8" IRON ROD WITH YELLOW PLASTIC CAP STAMPED LS 951 BEARS N 34°23'33" E, 976.40'.  
 FOUND 5/8" IRON ROD WITH YELLOW PLASTIC CAP STAMPED LS 951 BEARS S 88°45'43" W, 151.67'.  
 FOUND 5/8" IRON ROD WITH YELLOW PLASTIC CAP STAMPED LS 951 BEARS S 11°19'00" W, 770.17'.  
 FOUND 5/8" IRON ROD WITH YELLOW PLASTIC CAP STAMPED LS 951 BEARS S 23°32'37" E, 1526.06'.

MONUMENT DETAIL

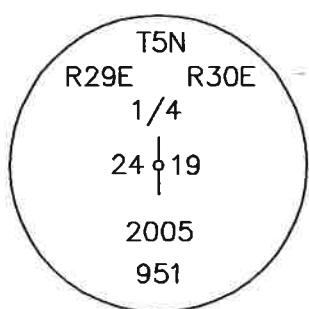

NAD 83/91  
 OREGON STATE PLANE  
 INTERNATIONAL FEET

817385.69  
 8553387.19

MONUMENT SET ( PROCEDURES AND DESCRIPTION )

NEW ACCESSORIES FROM WHICH

LOCATION AND COMMENTS

FROM INTERSECTION OF COLD SPRINGS HIGHWAY AND WALLS ROAD GO SOUTHWESTERLY ALONG WALLS ROAD +/- 1.35 MILES TO WHERE A CROP CIRCLE IS TANGENT WITH WALLS ROAD, THEN GO COUNTER CLOCKWISE AROUND SAID CROP CIRCLE +/- 1800 FEET TO WHERE A SECOND CROP CIRCLE IS TANGENT WITH FIRST SAID CROP CIRCLE, THEN GO CLOCKWISE AROUND SECOND CROP CIRCLE +/- 1200 FEET. CORNER FALLS EASTERLY INTO CROP CIRCLE +/- 150 FEET.

FIRM/AGENCY

PRIMM LAND SURVEYING, INC.  
 P.O. BOX 1322  
 HERMISTON, OREGON 97838

LAND SURVEYOR

BRIT L. PRIMM

WITNESS

KEITH P. PRIMM

SURVEYOR'S SEAL

REGISTERED  
 PROFESSIONAL  
 LAND SURVEYOR

*Brit L. Primm*

OREGON  
 JULY 13, 1999  
 BRIT L. PRIMM  
 48509

EXPIRATION DATE: 12/31/24