

OREGON CORNER RESTORATION FORM

SECTION 19, 20 TOWNSHIP 5 NORTH RANGE 29 EAST
COUNTY : UMATILLA DATE DEC/22

P-5

CORNER DESIGNATION

1/4 CORNER

CONDITION REPORT ONLY

NOT FOUND

RENEWED

UNCOVERED

SURVEYED IN

REFERENCED


PREVIOUS RENEWALS / SURVEYS, ETC.

SURVEYED IN 1861 BY DAVENPORT UNDER CONTRACT #101, HE SET POST AND MADE MOUND.
IN 1995 ROGERS SET AN ALUMINUM CAP. NOT FOUND.
IN 1998 ROBERTS SET A 2 3/8" BRASS CAP.

MONUMENTS AND ACCESSORIES FOUND: CONDITION AND SOURCE

FOUND 2 3/8" BRASS CAP STAMPED AS BELOW.
FOUND 5/8" IRON ROD WITH YELLOW PLASTIC CAP STAMPED LS 2627 BEARS N 30°45'29" E, 60.55'.
FOUND 5/8" IRON ROD WITH YELLOW PLASTIC CAP STAMPED LS 2627 BEARS N 18°43'43" W, 54.36'.
FOUND 5/8" IRON ROD WITH YELLOW PLASTIC CAP STAMPED LS 2627 BEARS S 40°24'51" W, 14.41'.
FOUND 5/8" IRON ROD WITH YELLOW PLASTIC CAP STAMPED LS 2627 BEARS S 38°16'32" E, 11.58'.

MONUMENT DETAIL

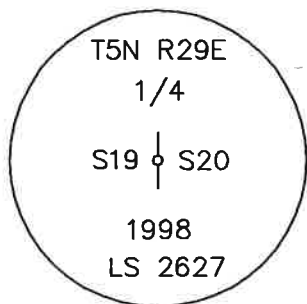

NAD 83/91
OREGON STATE PLANE
INTERNATIONAL FEET

817010.37
8526962.50

MONUMENT SET (PROCEDURES AND DESCRIPTION)

NEW ACCESSORIES FROM WHICH

LOCATION AND COMMENTS

CORNER FALLS SOUTHWEST OF
INTERSECTION OF CRAIG ROAD AND
PURDY ROAD.

FIRM/AGENCY

PRIMM LAND SURVEYING, INC.
P.O. BOX 1322
HERMISTON, OREGON 97838

LAND SURVEYOR

BRIT L. PRIMM

WITNESS

KEITH P. PRIMM

SURVEYOR'S SEAL

REGISTERED
PROFESSIONAL
LAND SURVEYOR

OREGON
JULY 13, 1999
BRIT L. PRIMM
48509

EXPIRATION DATE: 12/31/24

23-012-C