

# OREGON CORNER RESTORATION FORM

SECTION 20, 29 TOWNSHIP 5 NORTH RANGE 29 EAST  
COUNTY : UMATILLA DATE DEC/22

R-7

CORNER DESIGNATION

1/4 CORNER

- CONDITION REPORT ONLY
- NOT FOUND
- RENEWED
- UNCOVERED
- SURVEYED IN
- REFERENCED

PREVIOUS RENEWALS / SURVEYS, ETC.


SURVEYED IN 1861 BY DAVENPORT UNDER CONTRACT #101, HE SET POST AND MADE MOUND.  
IN 1910 KIMBRELL SET 2" IRON PIPE.  
IN 2000 ROBERTS SET A 2" ALUMINUM CAP.

MONUMENTS AND ACCESSORIES FOUND: CONDITION AND SOURCE

FOUND 2" ALUMINUM CAP STAMPED AS BELOW.  
FOUND 5/8" IRON ROD WITH PLASTIC CAP STAMPED LS 2627 BEARS N 89°14'30" W, 99.99'.  
FOUND 5/8" IRON ROD WITH PLASTIC CAP STAMPED LS 2627 BEARS N 74°51'13" W, 28.22'.

MONUMENT DETAIL

CAP IS ROTATED 90°

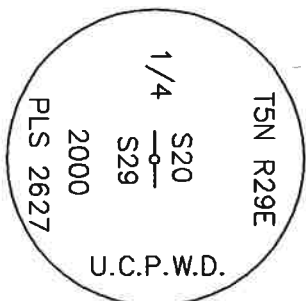

NAD 83/91  
OREGON STATE PLANE  
INTERNATIONAL FEET

814383.14  
8529664.74

MONUMENT SET ( PROCEDURES AND DESCRIPTION )

NEW ACCESSORIES FROM WHICH

SET 5/8" X 30" IRON ROD WITH YELLOW PLASTIC CAP STAMPED PLS LS 48509 BEARS N 34°16'36" E, 45.55'.  
SET 5/8" X 30" IRON ROD WITH YELLOW PLASTIC CAP STAMPED PLS LS 48509 BEARS S 23°18'42" W, 195.05'.

LOCATION AND COMMENTS

FROM INTERSECTION OF CRAIG ROAD  
AND PROGRESS ROAD GO EAST  
ALONG PROGRESS ROAD +/- 0.5  
MILES TO CORNER.

FIRM/AGENCY

PRIMM LAND SURVEYING, INC.  
P.O. BOX 1322  
HERMISTON, OREGON 97838

LAND SURVEYOR

BRIT L. PRIMM

WITNESS

KEITH P. PRIMM

SURVEYOR'S SEAL

REGISTERED  
PROFESSIONAL  
LAND SURVEYOR

*Brit L. Primm*  
OREGON  
JULY 13, 1999  
BRIT L. PRIMM  
48509

EXPIRATION DATE: 12/31/24